


F-715 A & B
PARTICULATE FILTER
SEPARATOR

SIZE: 18" O.D. x 42.5" T/T
OPERATING: 230 PSIG
DESIGN: 275 PSIG @ 100°F
MDMT: -20°F @ 275 PSIG
DESIGN CAP: 180 GPM @ 2.25 PSID CLEAN

47
46
45
47
46
45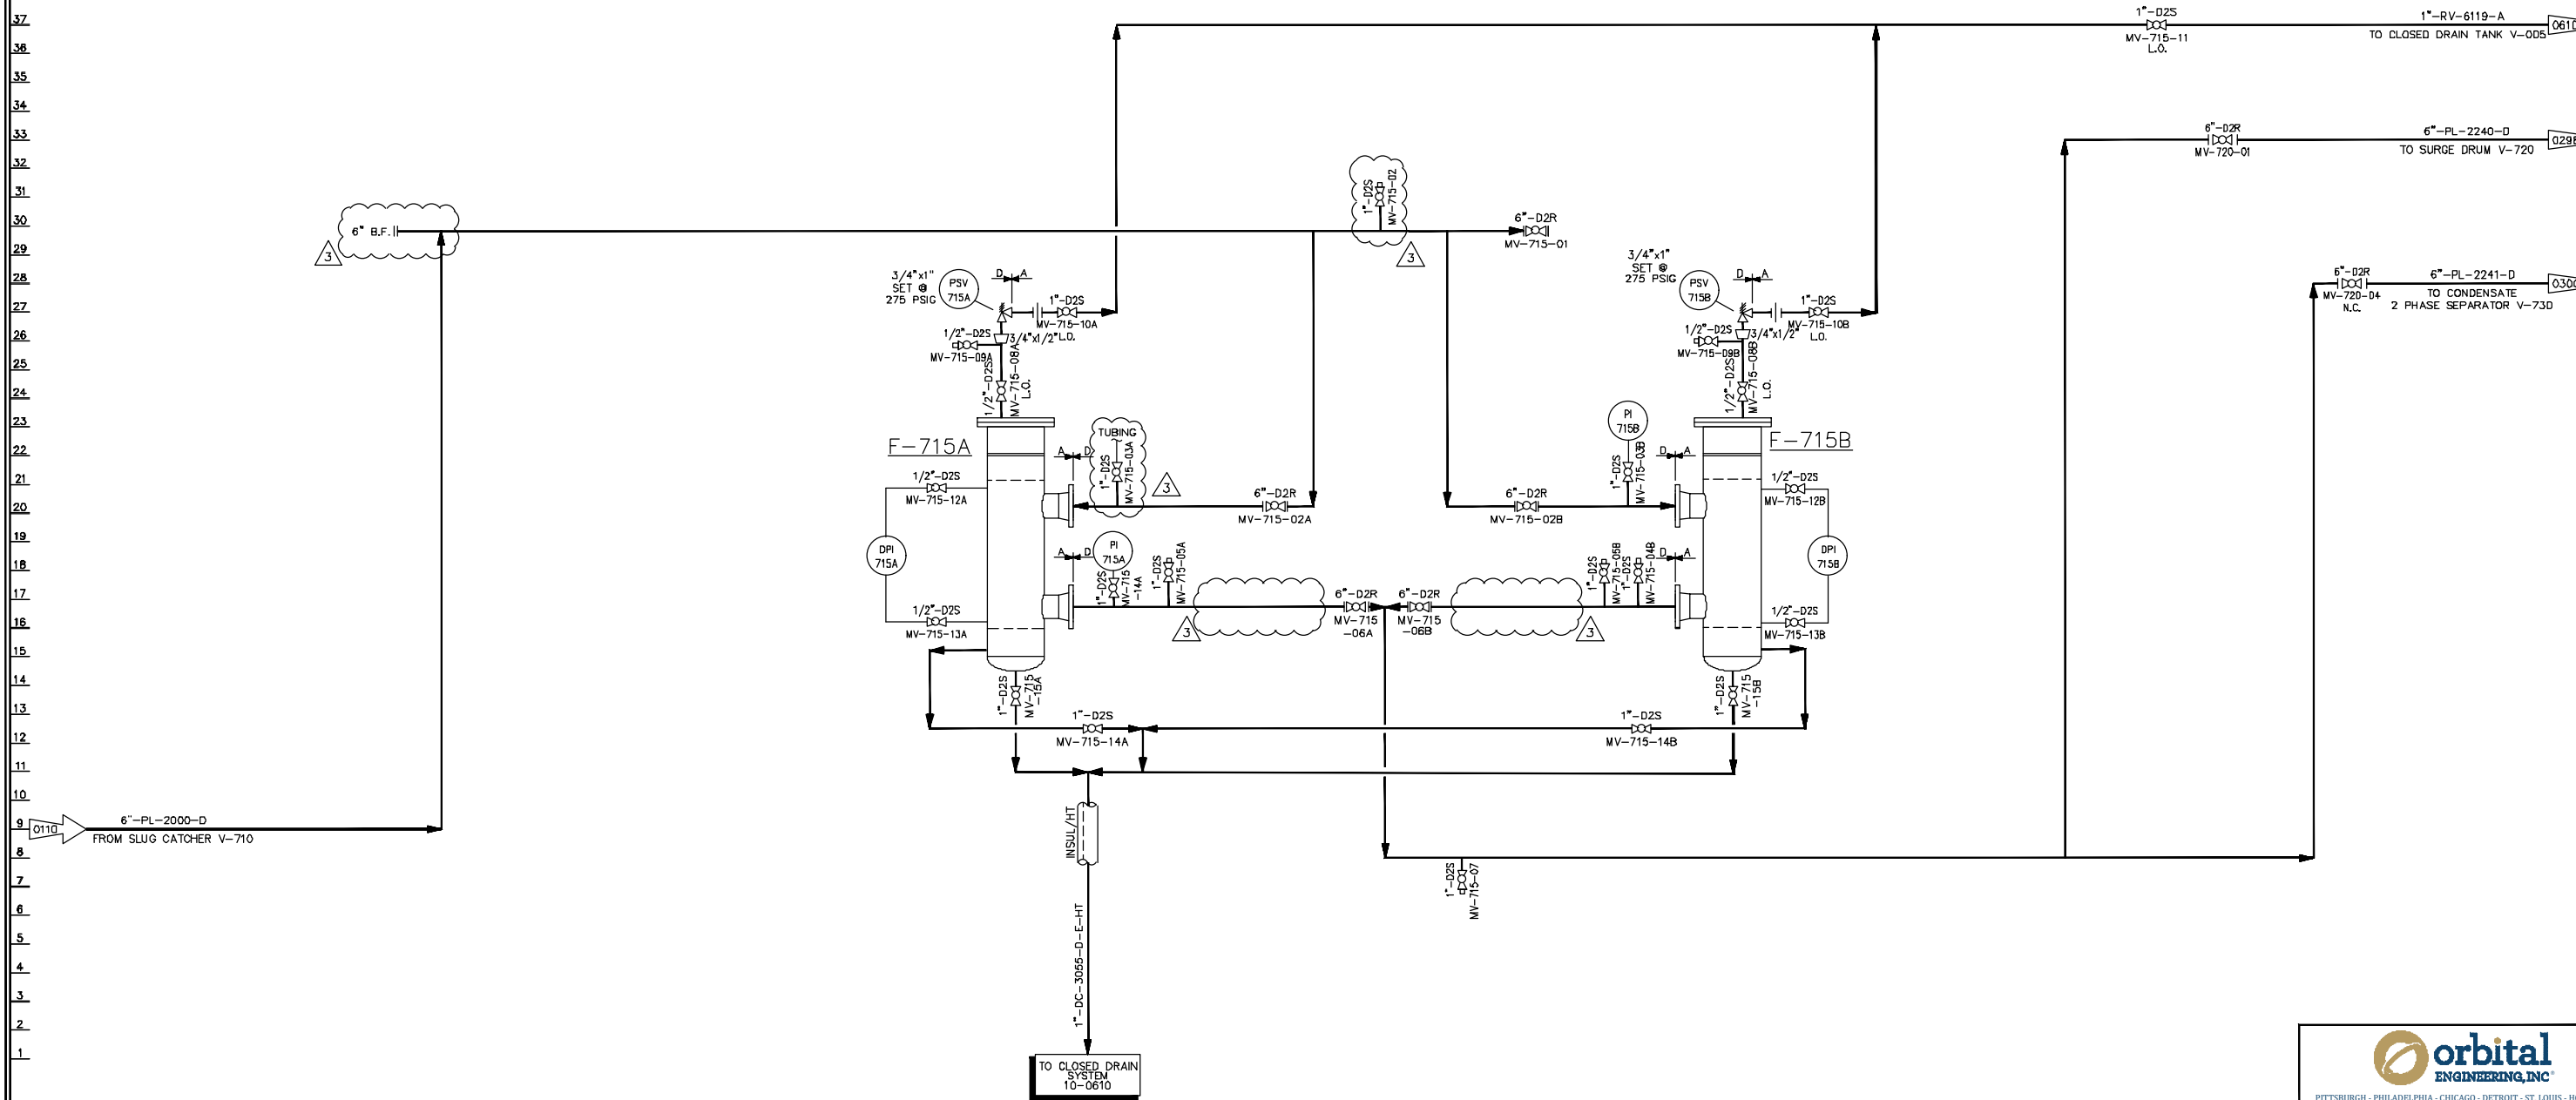
PROJECT PIT.22.7136




MARCELLUS SHALE DEVELOPMENT
MAJORSVILLE CGP
PIPING & INSTRUMENTATION DIAGRAM
PARTICULATE FILTER SEPARATORS

REV.	DESCRIPTION	BY	CHK'D	APP'D	DATE	DRAWN	PH	03/11/14
3	AS-BUILT FOR PHA	RCA	KBK	JMM	04/01/22			
2	MOC# 05242016	BMS	CB	BMS	09/06/16	CLIENT	-	-
1	AS-BUILT	CNH	KRE	BMS	08/24/15	APPROVED	JD	03/11/14
0	ISSUED FOR CONSTRUCTION	PH	JC	JD	03/11/14	CHECKED	JC	03/11/14

JOB NO. 009963.001 DWG. NO. MJV-CGP-10-0297

47
46
45
47
46
45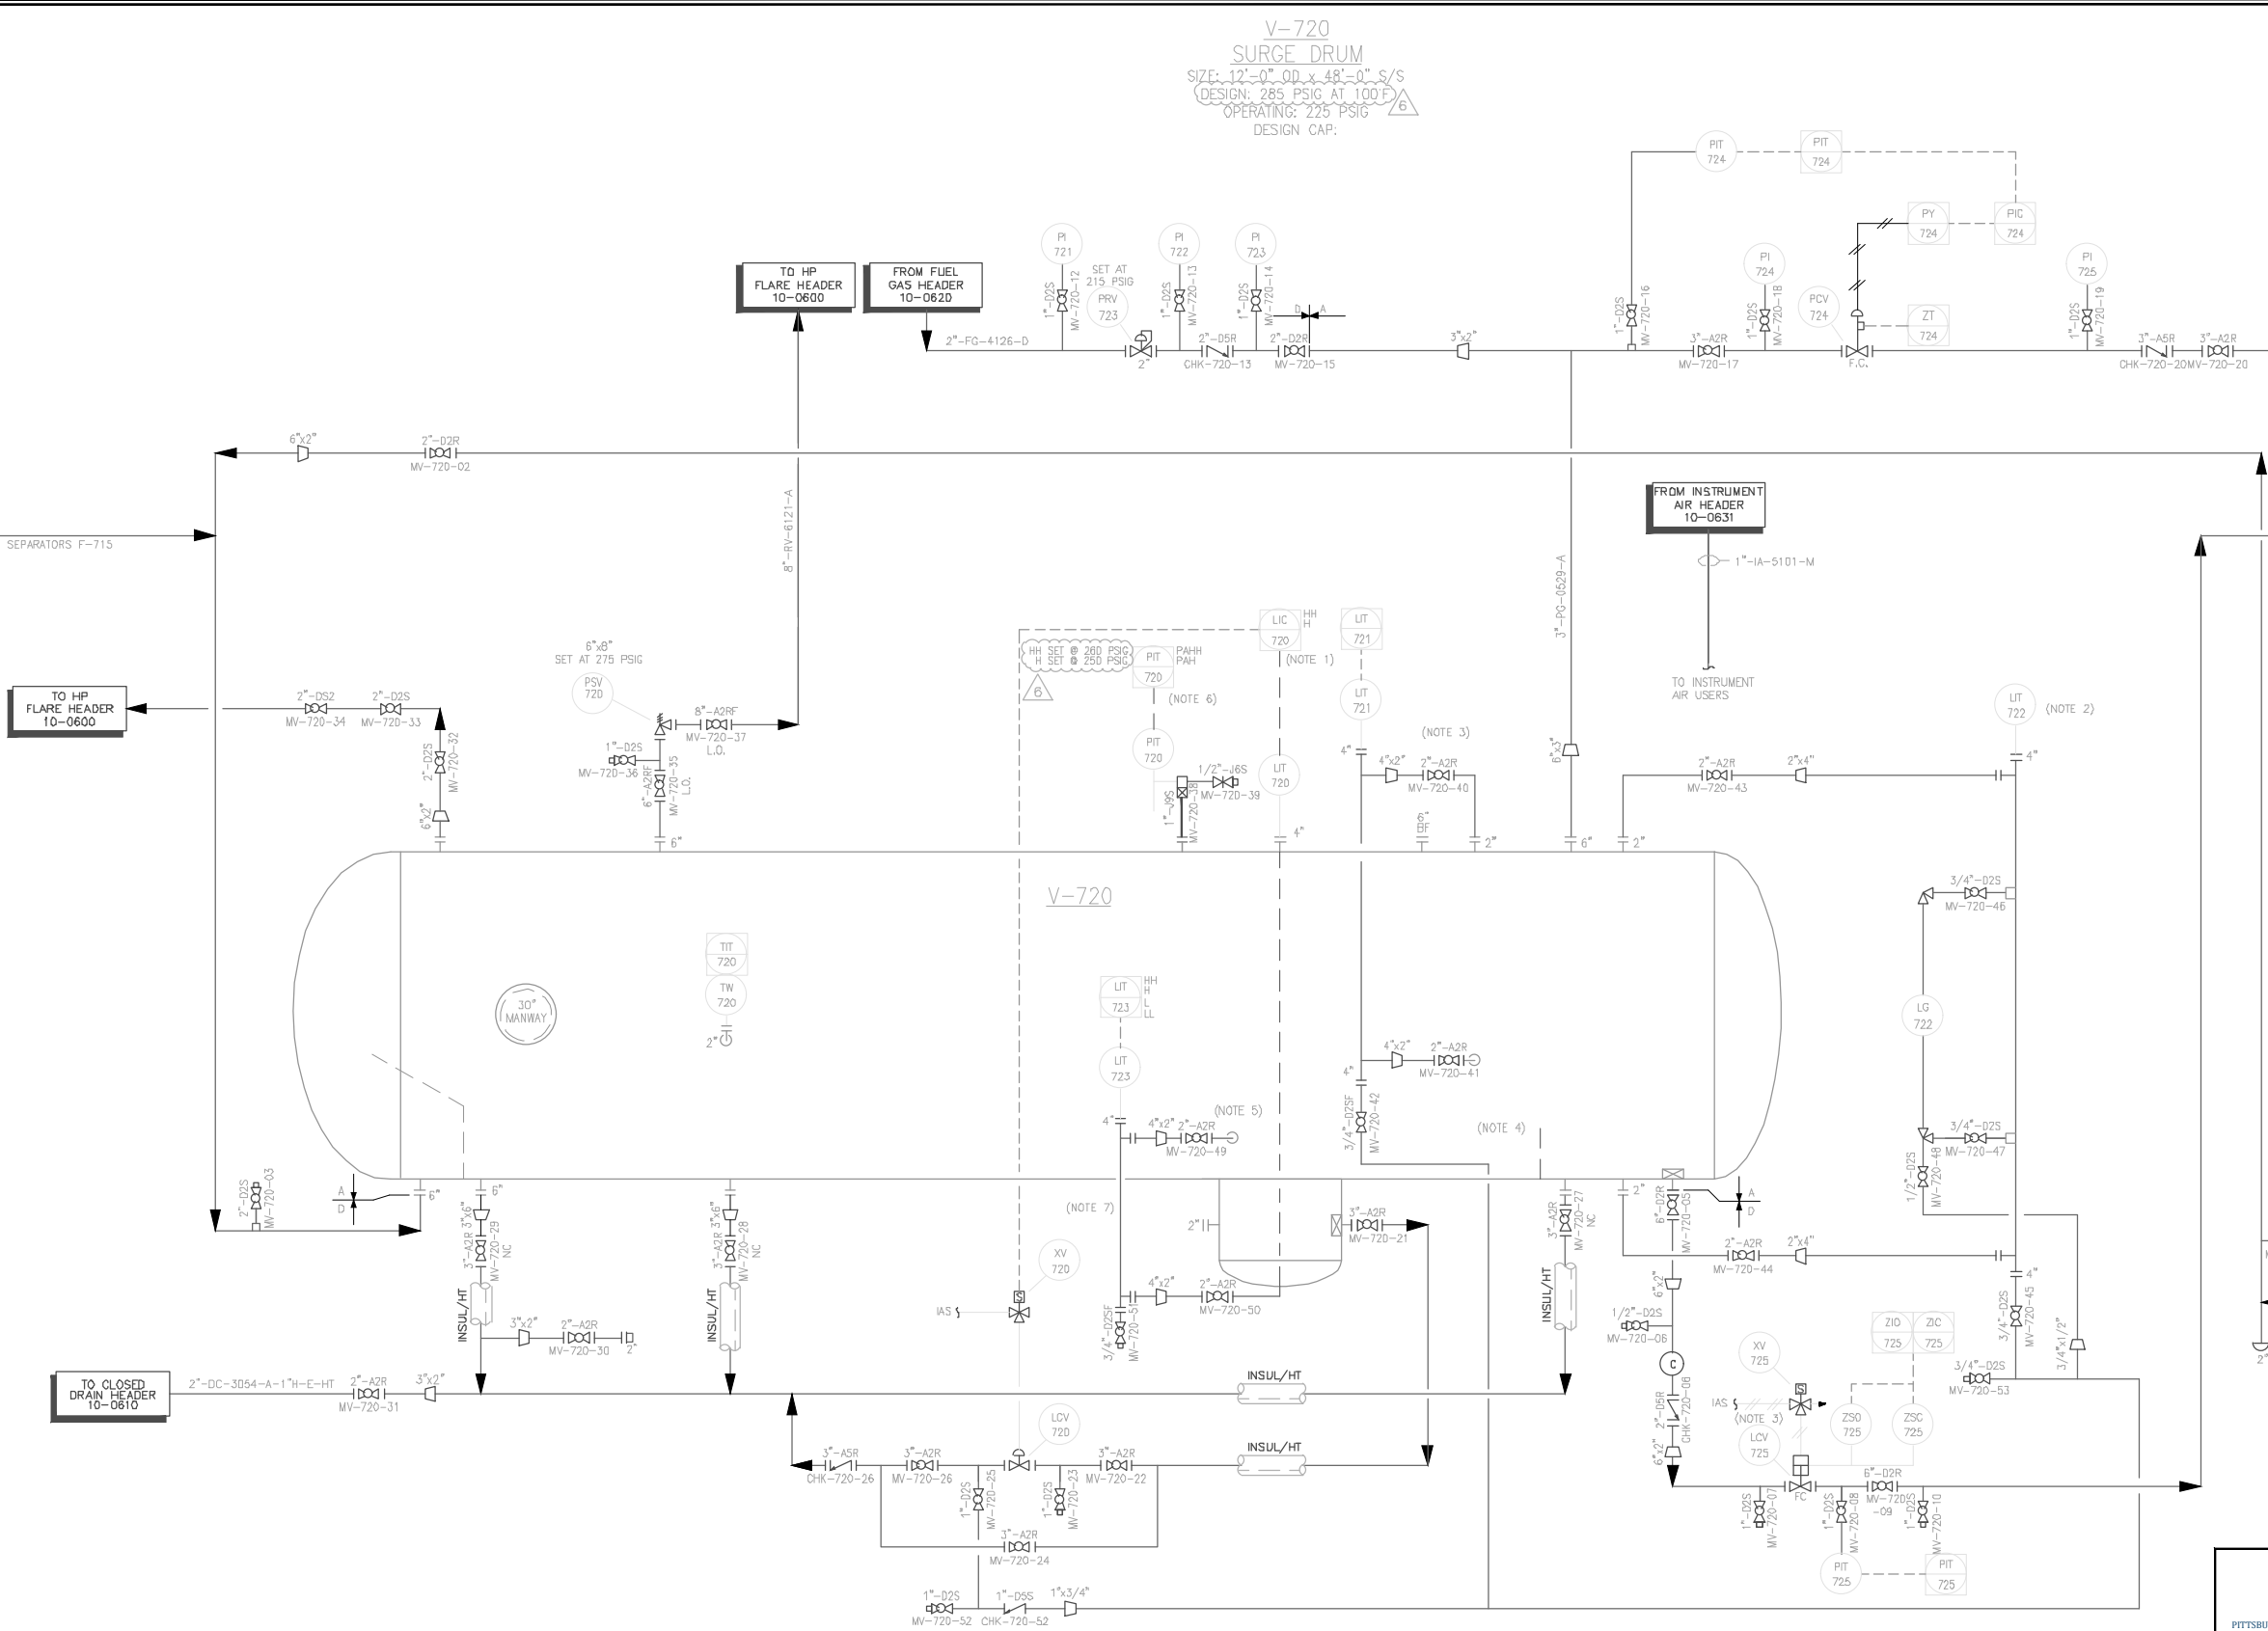
- NOTES:
1. LIT-720 IS GUIDED WAVE RADAR INSTRUMENT AND WILL MEASURE INTERFACE & OVERALL LEVEL. UC-720 WILL OPEN LCV-720 ON HIGH WATER/HYDROCARBON INTERFACE LEVEL TO ALLOW WATER TO EXIT BOOT. LAH & LAHH WILL ANNUNCIATE WITH RESPECT TO WATER LEVEL IN VESSEL. LAHH-720 WILL INTERLOCK SDV-700 CLOSED ON MJV-CGP-10-0110.
 2. LIT-722 IS GUIDED WAVE RADAR AND MEASURES CONDENSATE LEVEL. HIGH HIGH LEVEL WILL CLOSE SDV-700 ON MJV-CGP-10-0110. LOW LOW LEVEL WILL CLOSE LCV-725.
 3. LEVEL INSTRUMENT *721* MEASURES CONDENSATE LEVEL. HIGH HIGH LEVEL WILL CLOSE SDV-700 ON MJV-CGP-10-0110. LOW LOW LEVEL WILL CLOSE LCV-725.
 4. TOP OF WIER IS LOCATED 3" BELOW THE LOWER BRIDLE NOZZLE FOR LEVEL SWITCH 721.
 5. TOP OF WIER IS LOCATED 3" ABOVE THE LOWER BRIDLE NOZZLE FOR LIT-723.
 6. PIT-720 HH PRESSURE WILL CLOSE SDV-700 ON P&ID MJV-CGP-10-0110.
 7. LEVEL INSTRUMENT *723* WILL CONTROL BOOT WATER LEVEL. HIGH HIGH LEVEL WILL CLOSE SDV-700 ON MJV-CGP-10-0110. LOW LEVEL WILL CLOSE LCV-720.

REV.	DESCRIPTION	BY	CHK'D	APP'D	DATE	DRAWN	PH	03/11/14
6	REVISED PER PHA REDLINES	RCA	KBK	JMM	09/02/22			
5	AS-BUILT FOR PHA	RCA	KBK	JMM	04/01/22			
4	AS BUILTS	BMS	KE	BMS	12/09/15			
3	AS BUILT FOR CNX PER WALKDOWN AND MOC #05222015	KJR	CB	BS	06/11/15			
2	AS BUILT FOR CNX	KJR	GC	JM	07/11/14			
1	ISSUED FOR CONSTRUCTION - REVISED PER CLIENT COMMENTS	PH	JC	JD	03/31/14			
0	ISSUED FOR CONSTRUCTION	PH	JC	JD	03/11/14			



PROJECT PIT.22.7136




MARCELLUS SHALE DEVELOPMENT
MAJORSVILLE CGP
PIPING & INSTRUMENTATION DIAGRAM
SURGE DRUM

CLIENT	-	-
APPROVED	JD	03/11/14
CHECKED	JC	03/11/14


JOB NO.	009963.001
DWG. NO.	MJV-CGP-10-0298

SIZE: 36" I.D. x 143" T/T
DESIGN: 1440 PSIG @ 0/100°F
OPERATING: 225 PSIG @ 90°F
DESIGN CAP: 5000 BPD
REF SCHULTZ #: 11-1146-1P&ID

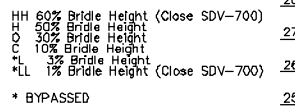



CONSOL ENERGY
America's On Shores

[illegible]

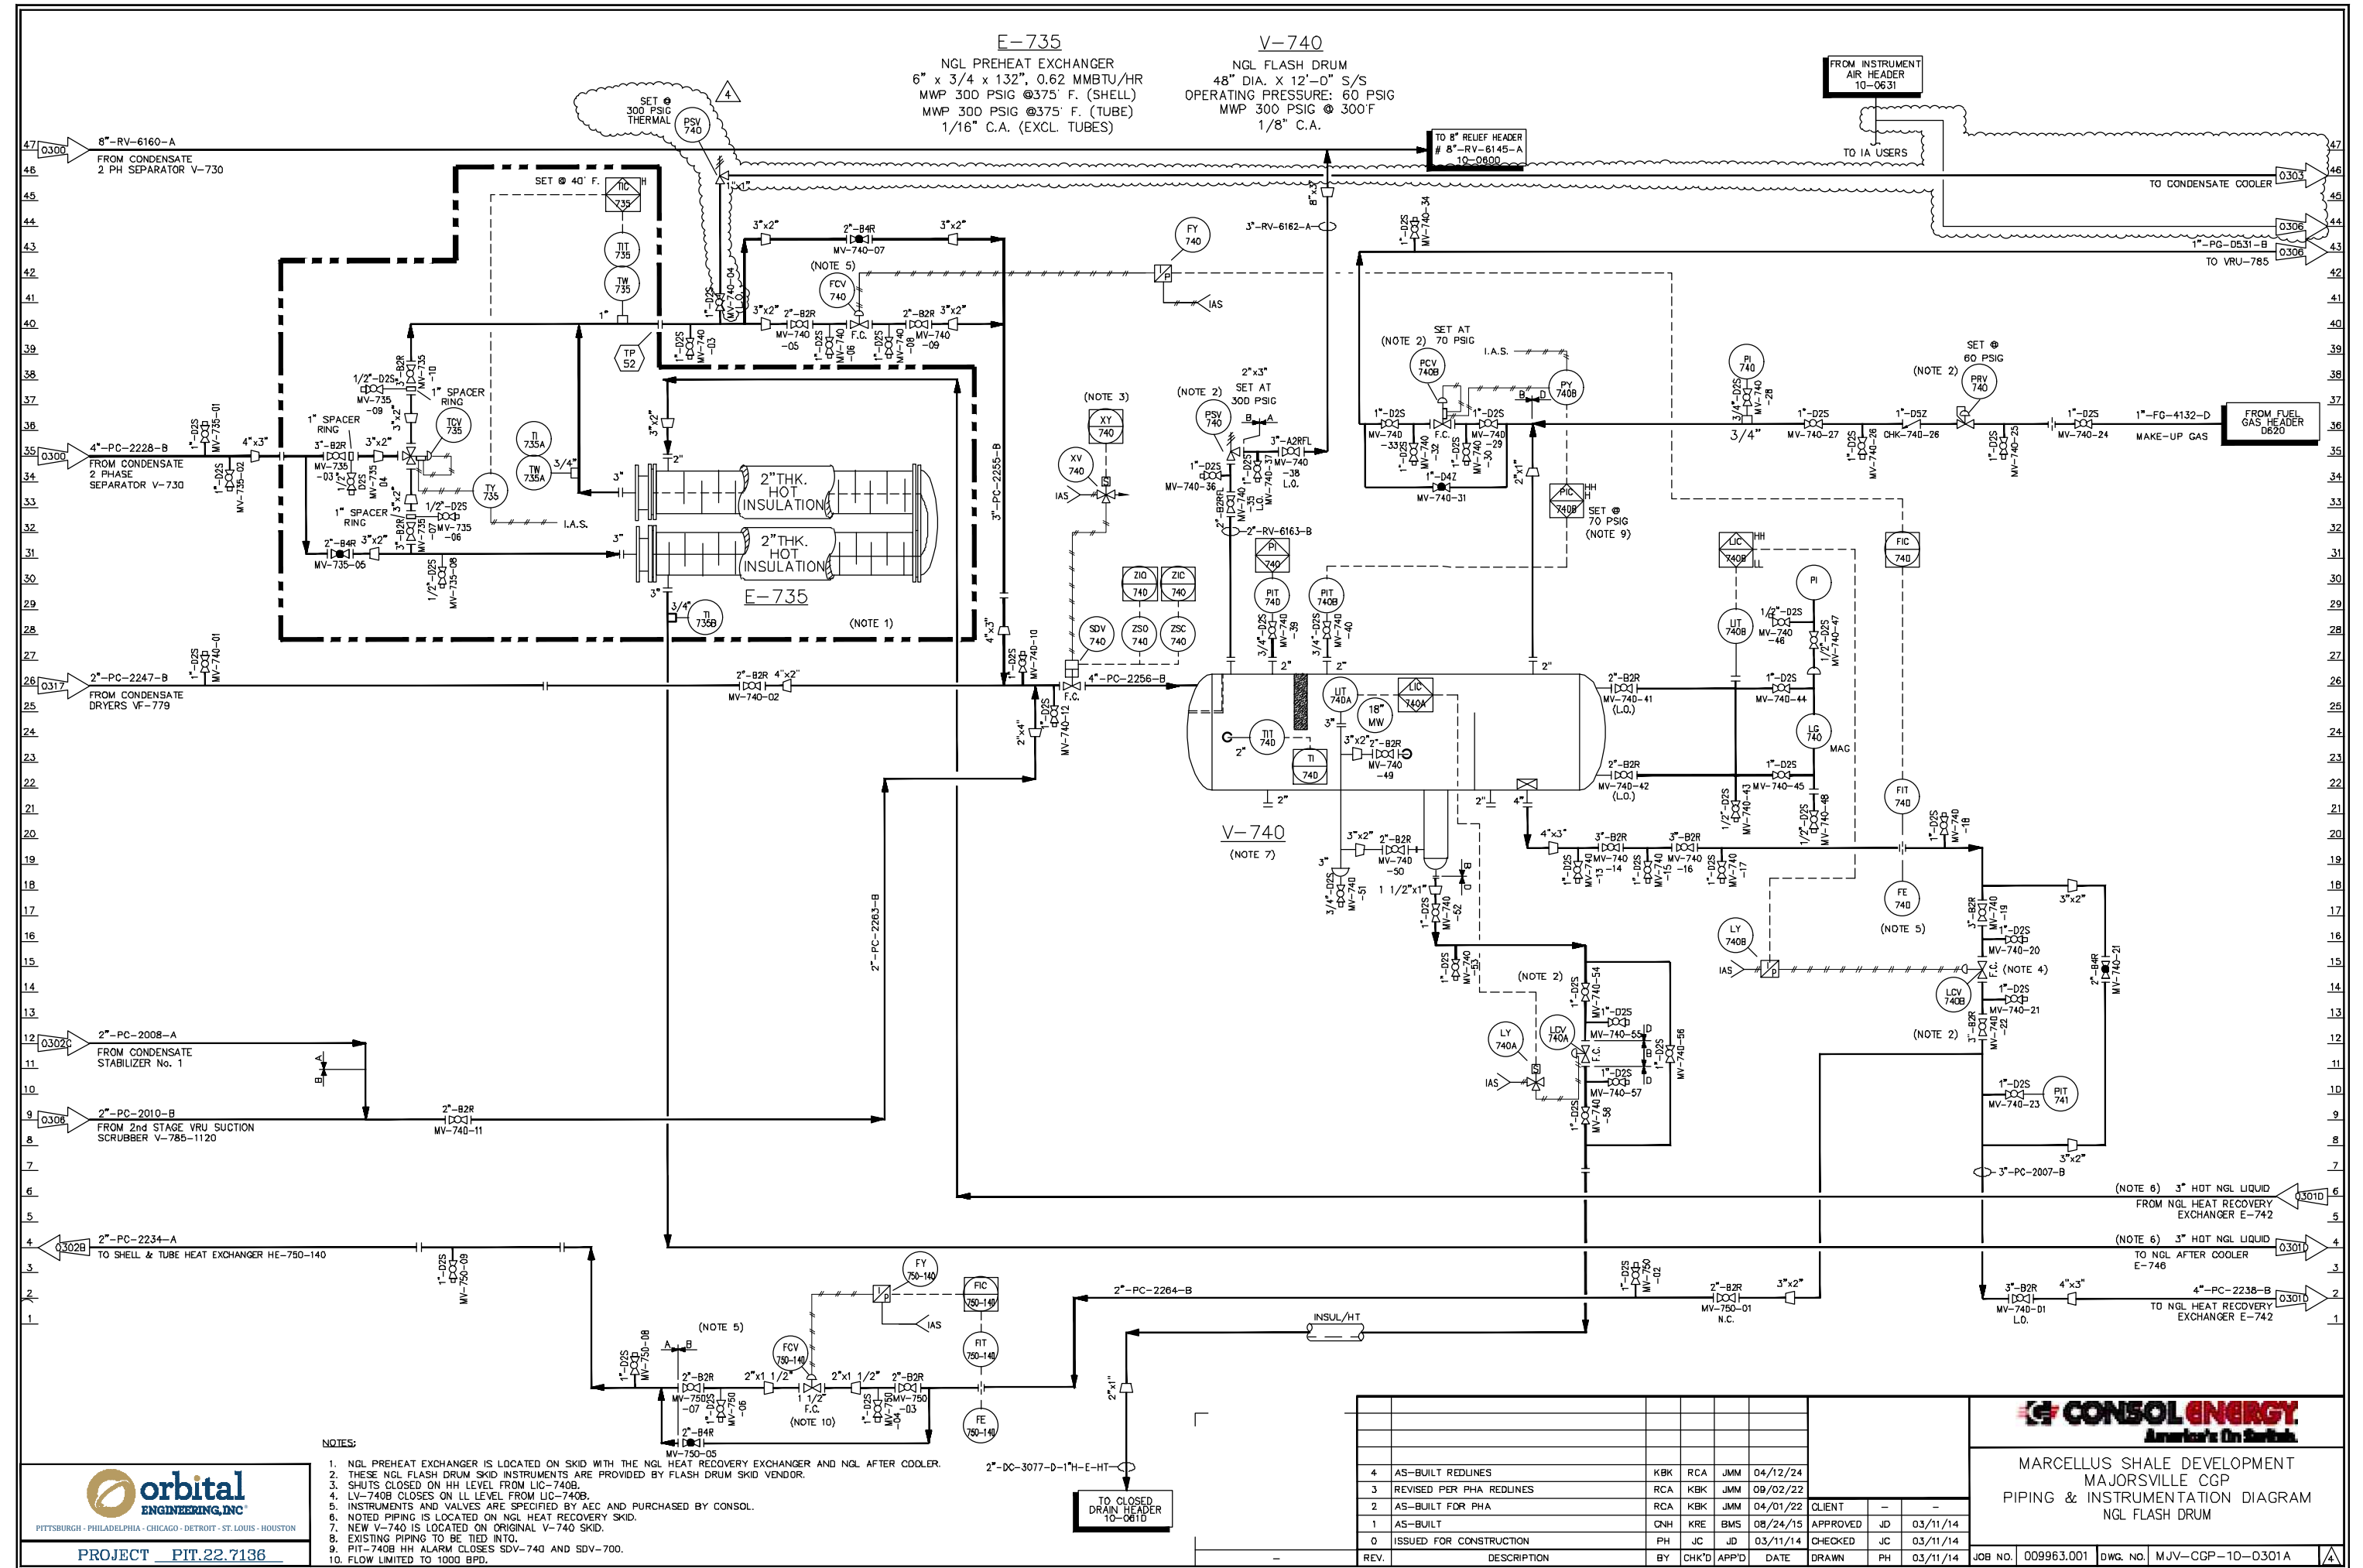

P-745
SUBMERSIBLE SUMP PUMP

V-745
NGL STABILIZER
30" OD X 55'-0" S/S TWO (2) 20' SECTIONS
M.W.P.: 300 PSIG @ 375' F
2" H

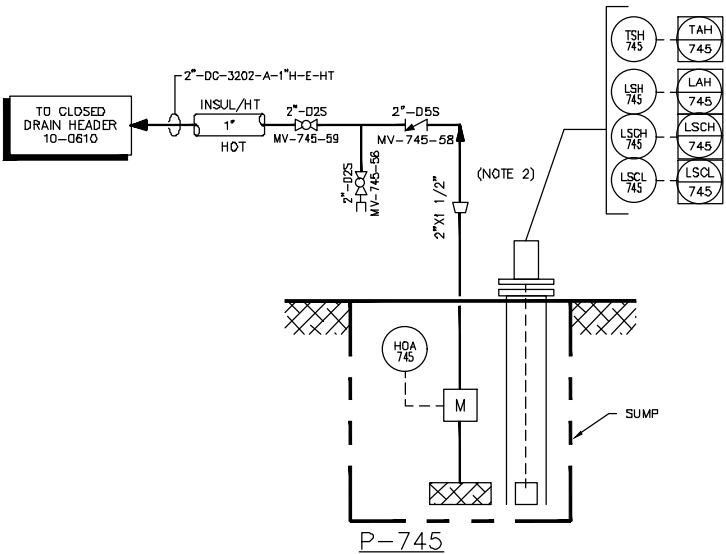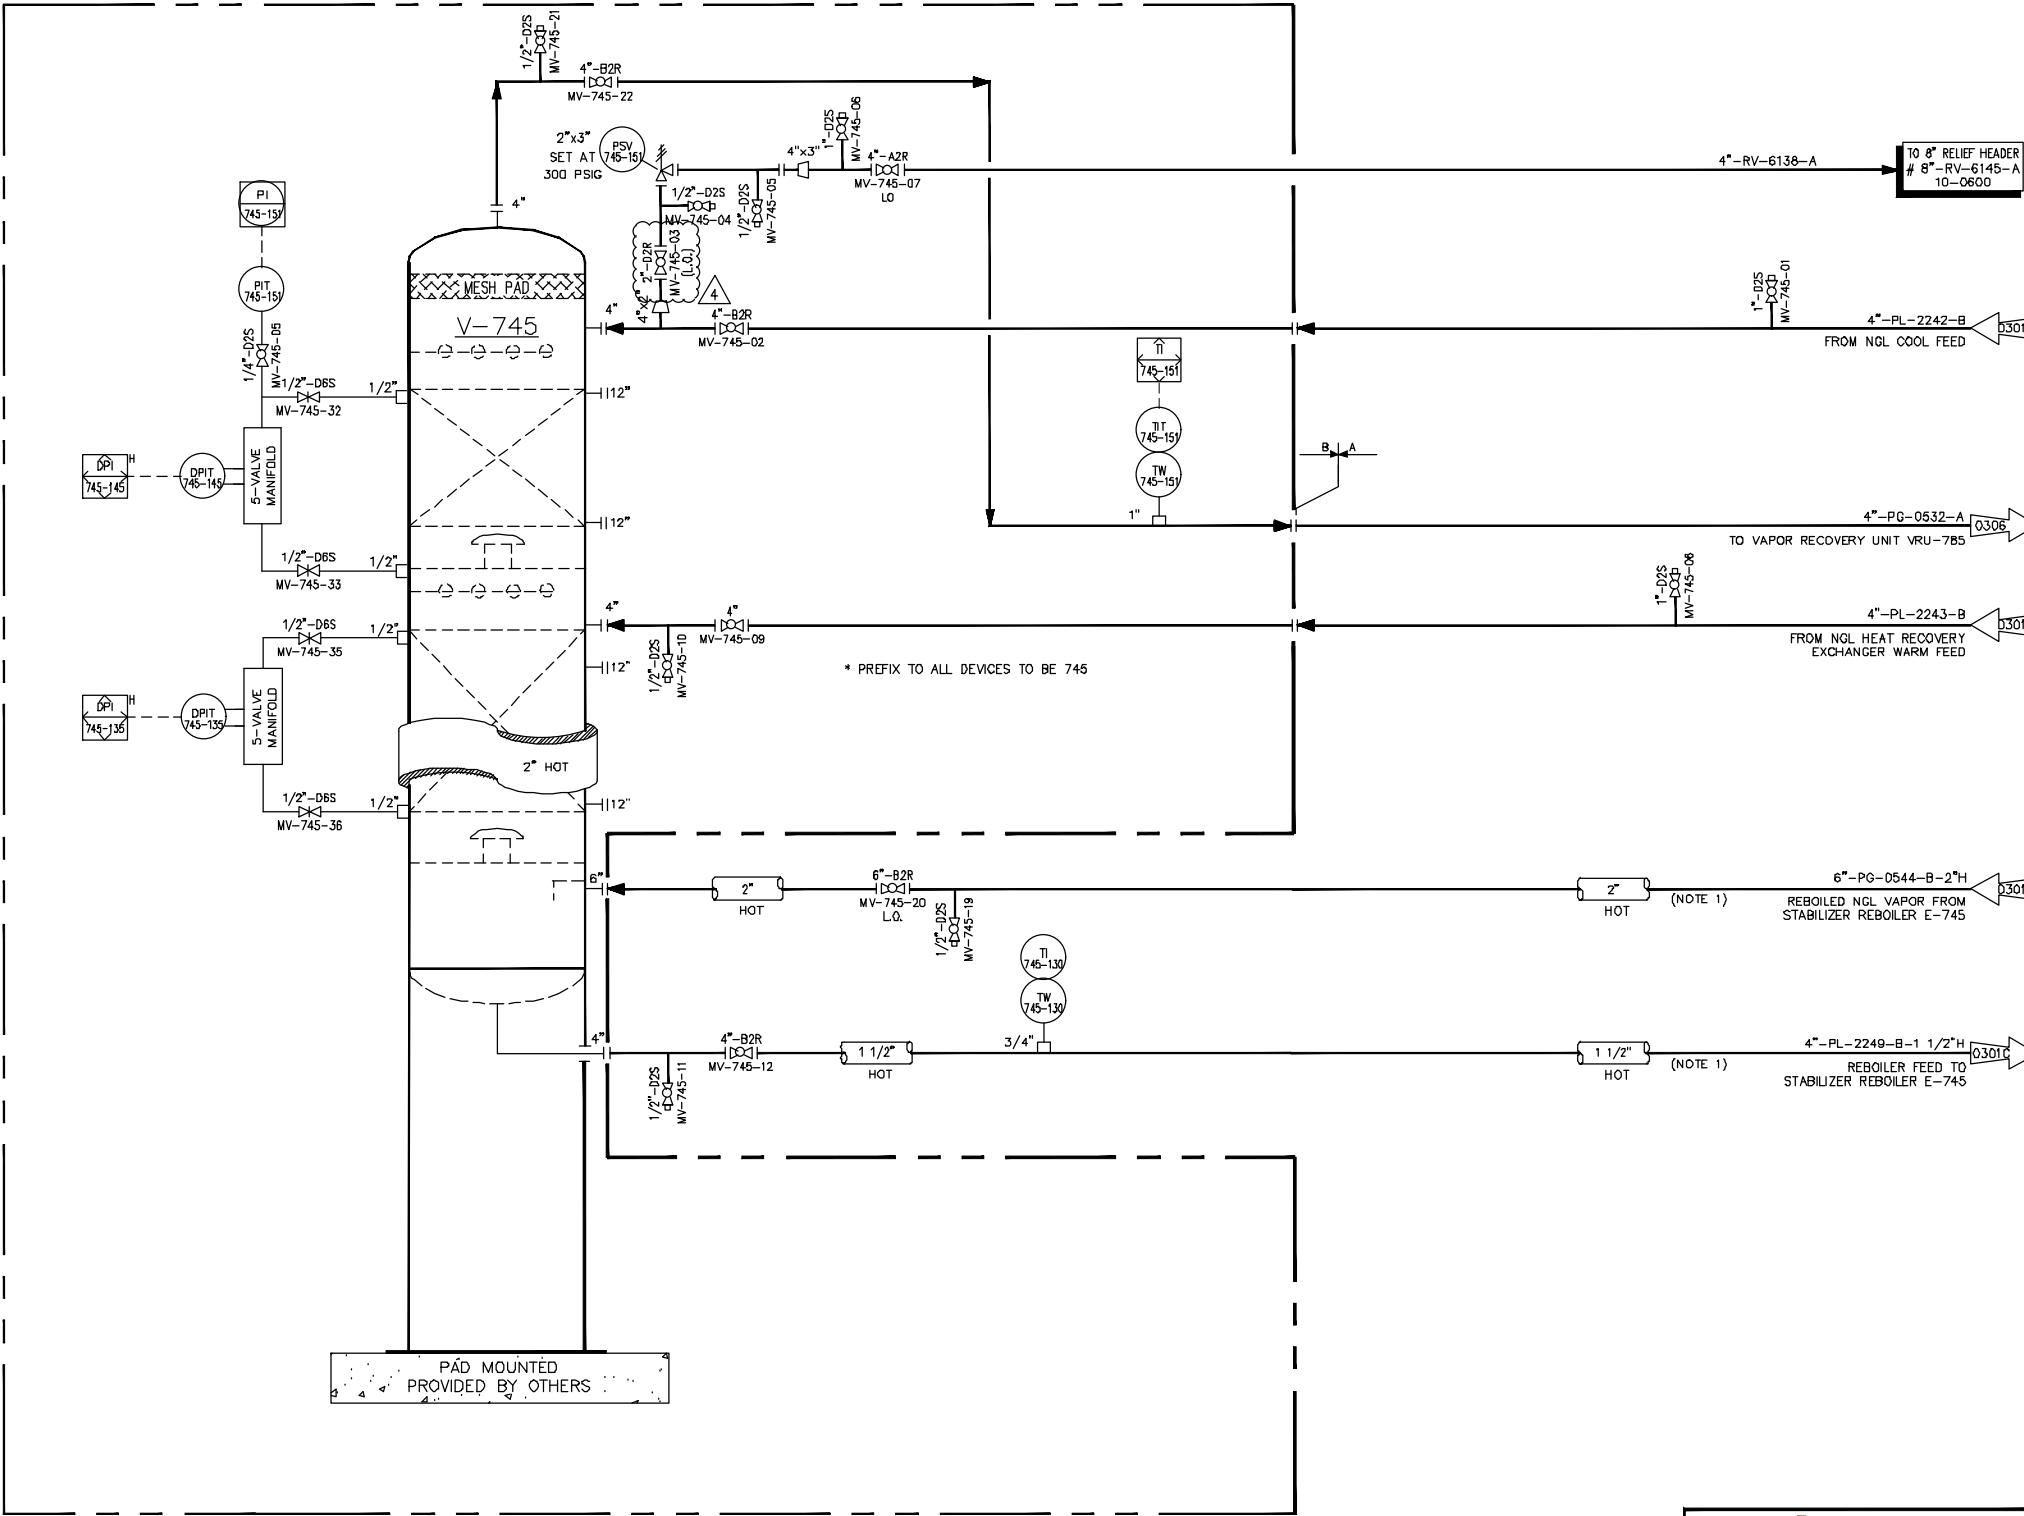

- NOTES:
1. VENDOR SUPPLIED PIPING.
 2. HIGH LEVEL WILL TURN ON SUMP PUMP. LOW LEVEL WILL TURN OFF SUMP PUMP.

REV.	DESCRIPTION	BY	CHK'D	APP'D	DATE	DRAWN	PH	03/11/14
5	REVISED PER PHA REDLINES	RCA	KBK	JMM	09/02/22			
4	AS-BUILT FOR PHA	RCA	KBK	JMM	04/01/22			
3	REVISED FOR MOC # 08282015	BMS	CB	BMS	09/18/15			
2	AS-BUILT	CNH	KRE	BMS	08/24/15			
1	IFC - REVISED PER HAZOP RECOMMENDATIONS	SS	EH	JC	04/18/14			
0	ISSUED FOR CONSTRUCTION	PH	JC	JD	03/11/14			




PROJECT PIT.22.7136



MARCELLUS SHALE DEVELOPMENT
MAJORSVILLE CGP
PIPING & INSTRUMENTATION DIAGRAM
NGL STABILIZER TOWER

JOB NO. 009963.001 DWG. NO. MJV-CGP-10-0301B


47
46
45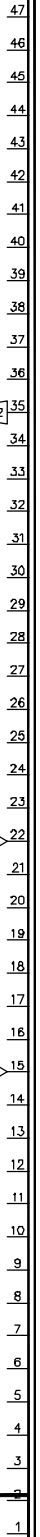
2	AS-BUILT FOR PHA	RCA	KBK	JMM	04/01/22	CJENT	-	-
1	AS-BUILT	CNH	KRE	BMS	08/24/15	APPROVED	JD	03/11/14
0	ISSUED FOR CONSTRUCTION	PH	JC	JD	03/11/14	CHECKED	JC	03/11/14
REV.	DESCRIPTION	BY	CHK'D	APP'D	DATE	DRAWN	PH	03/11/14

AC-746
NGL AFTER COOLER
1F12-090-1/2.1 MMBTU/HR. 15 HP 460/3/60
MWP 350 PSIG @ -20/400° F.
1/16" C.A. (EXCL. TUBES)

E-742
NGL HEAT RECOVERY EXCHANGER
4' X 3/4' X 240' .44MMBTU/HR
MWP 300 PSIG @ 375° F. (SHELL)
300 PSIG @ 250° F. (TUBE)
1/16" C.A. (EXCL. TUBES)

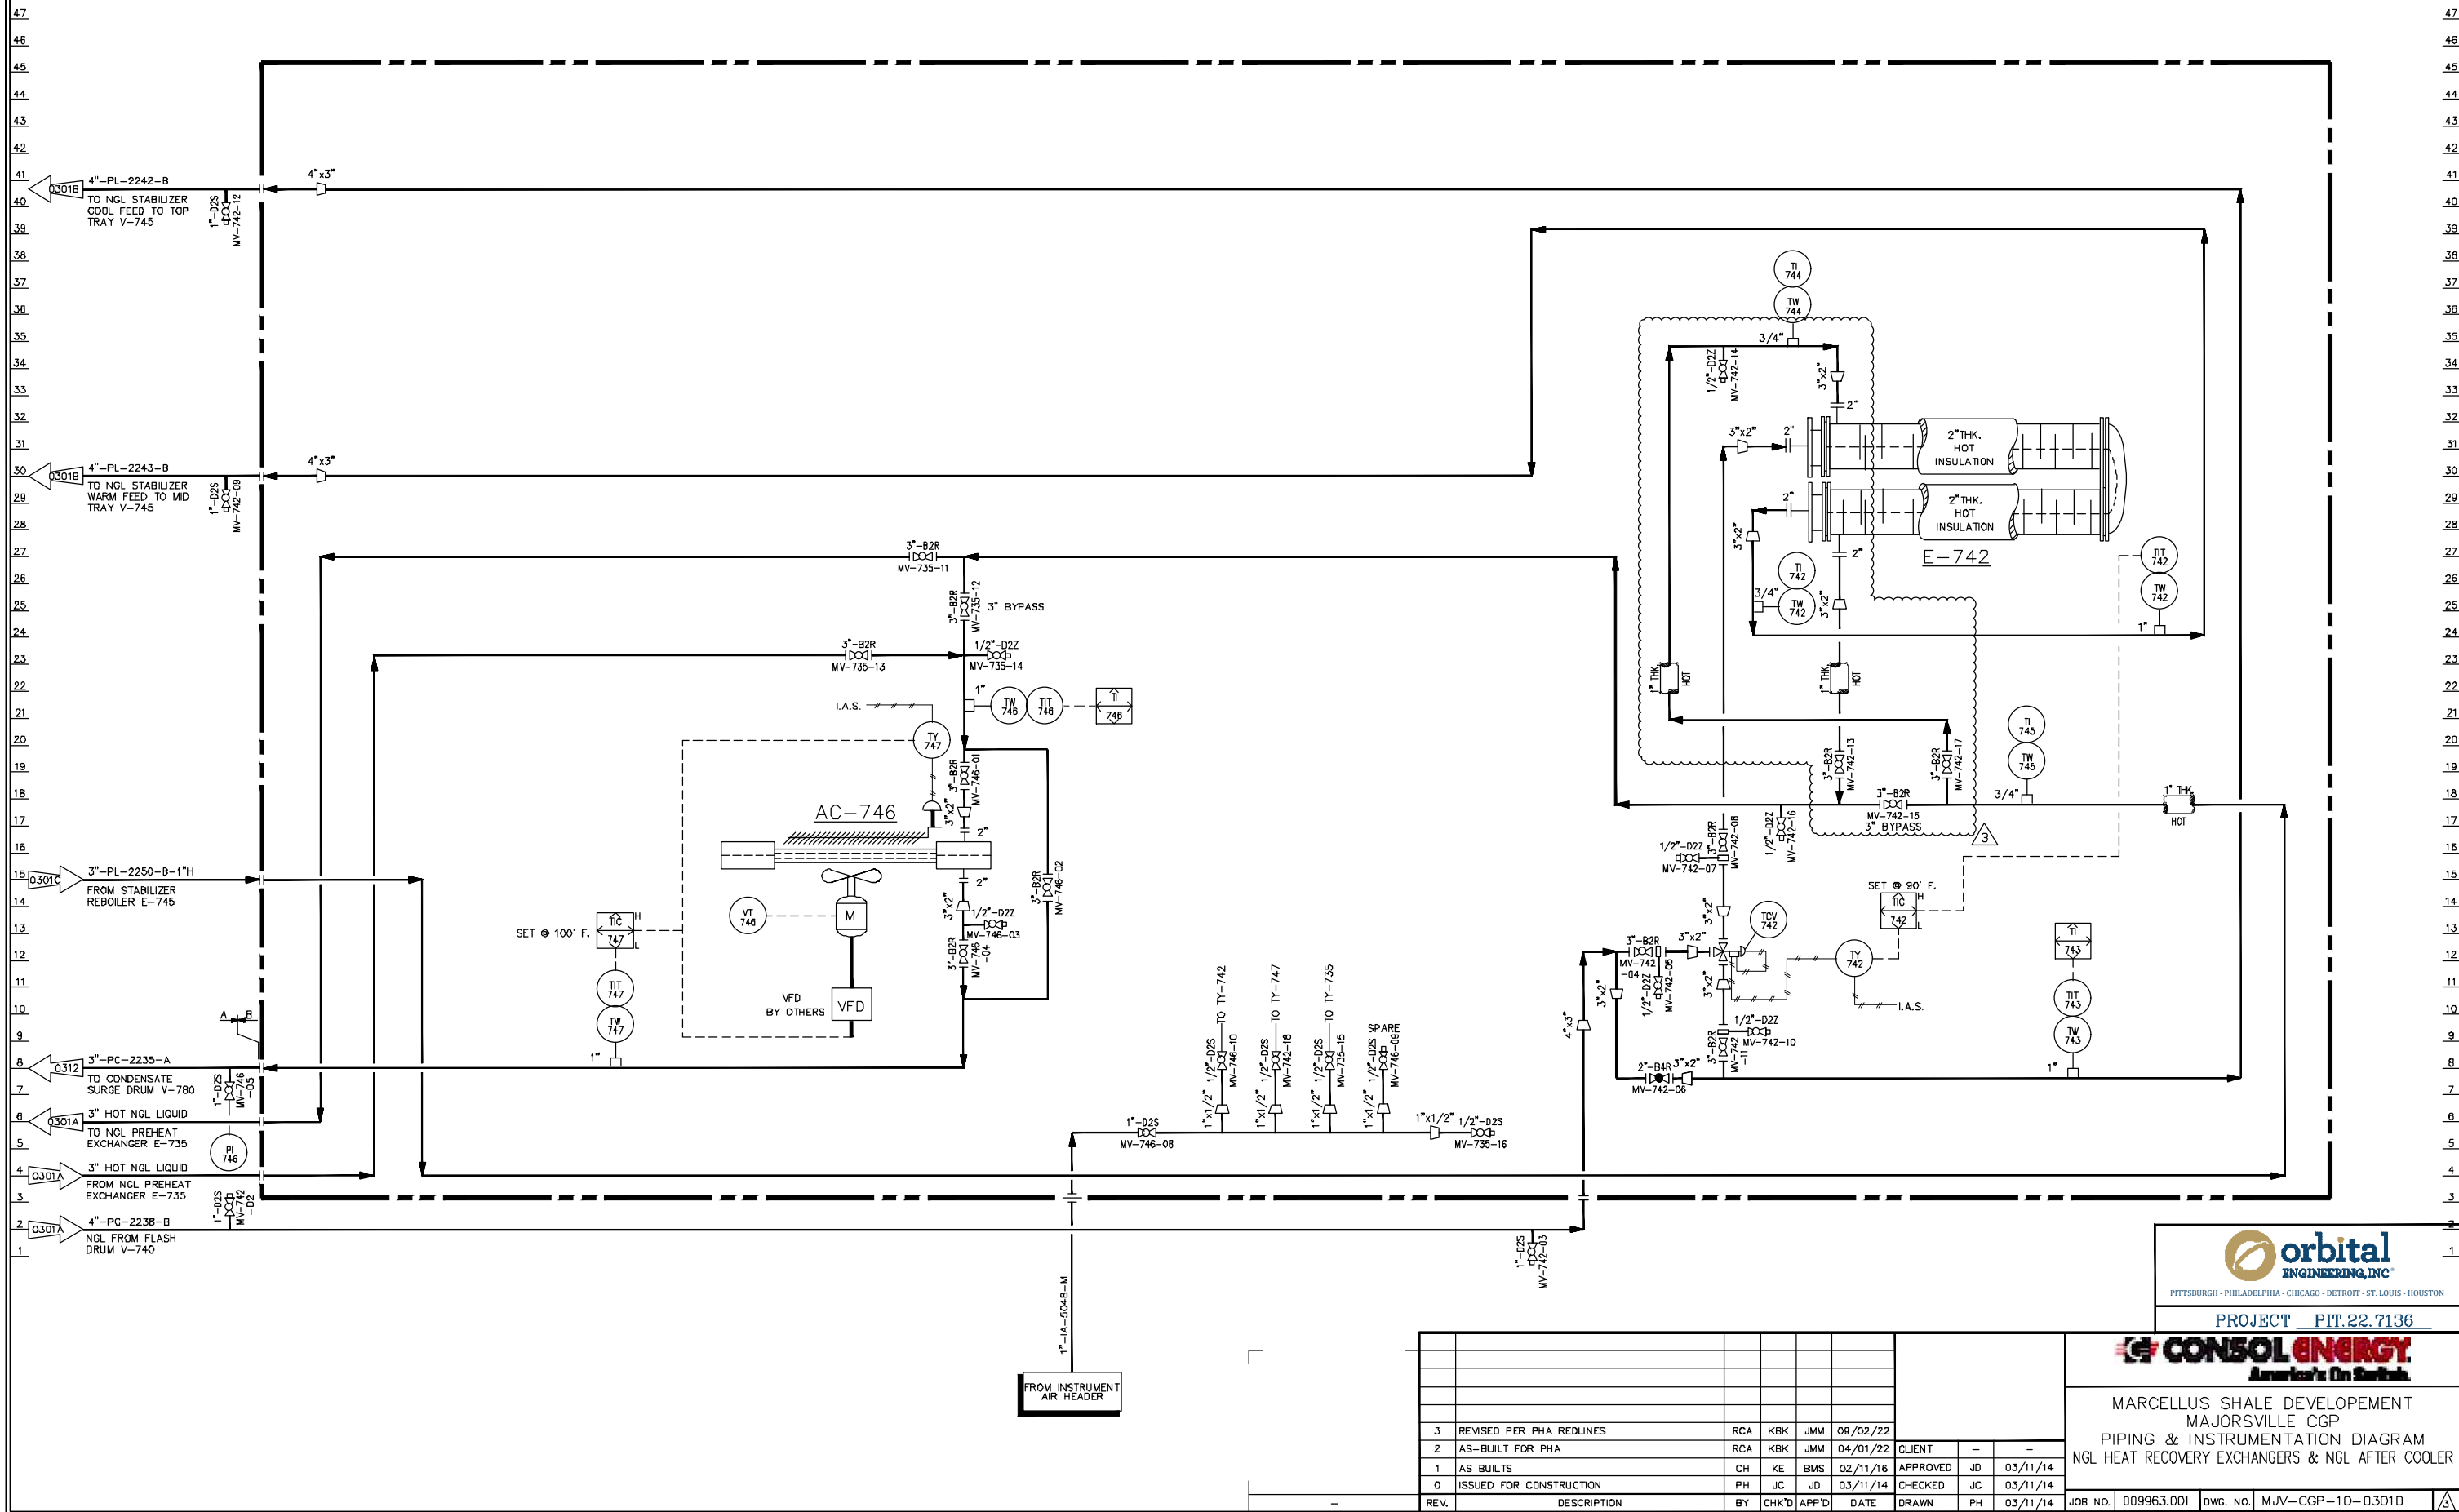

orbital
ENGINEERING, INC.
PITTSBURGH - PHILADELPHIA - CHICAGO - DETROIT - ST. LOUIS - HOUSTON

PROJECT PIT.22.7136

CONSOL ENERGY
America's On Shores.


MARCELLUS SHALE DEVELOPEMENT
MAJORSVILLE CGP
PIPING & INSTRUMENTATION DIAGRAM
NGL HEAT RECOVERY EXCHANGERS & NGL AFTER COOLER

REV.	DESCRIPTION	BY	CHK'D	APP'D	DATE	DRAWN	PH	03/11/14
3	REVISED PER PHA REDLINES	RCA	KBK	JMM	09/02/22			
2	AS-BUILT FOR PHA	RCA	KBK	JMM	04/01/22			
1	AS BUILTS	CH	KE	BMS	02/11/16	APPROVED	JD	03/11/14
0	ISSUED FOR CONSTRUCTION	PH	JC	JD	03/11/14	CHECKED	JC	03/11/14

ET-750-100
EXPANSION TANK
16" OD X 5'-0" S/S
DESIGN PRESSURE: ATMOS.
DESIGN TEMPERATURE: XXX

HTR-750-100
INDIRECT HEATER
INTERNAL: ATMOS. @ XXX
36" OD X 14'-0" L
N/A
C.A.: 0
N.D.E. TESTING: RT-?
5 LATERALS WITH 2" XH COILS
4 PASSES EACH LAT (TOTAL 20 PASSES)

V-750-120
FUEL GAS SCRUBBER
INTERNAL: PRESSINT @ TEMPINT
OD X LENGTH
CODE
C.A.: CORROSION
N.D.E. TESTING: XRAY
(RATED TO 250 PSIG) A

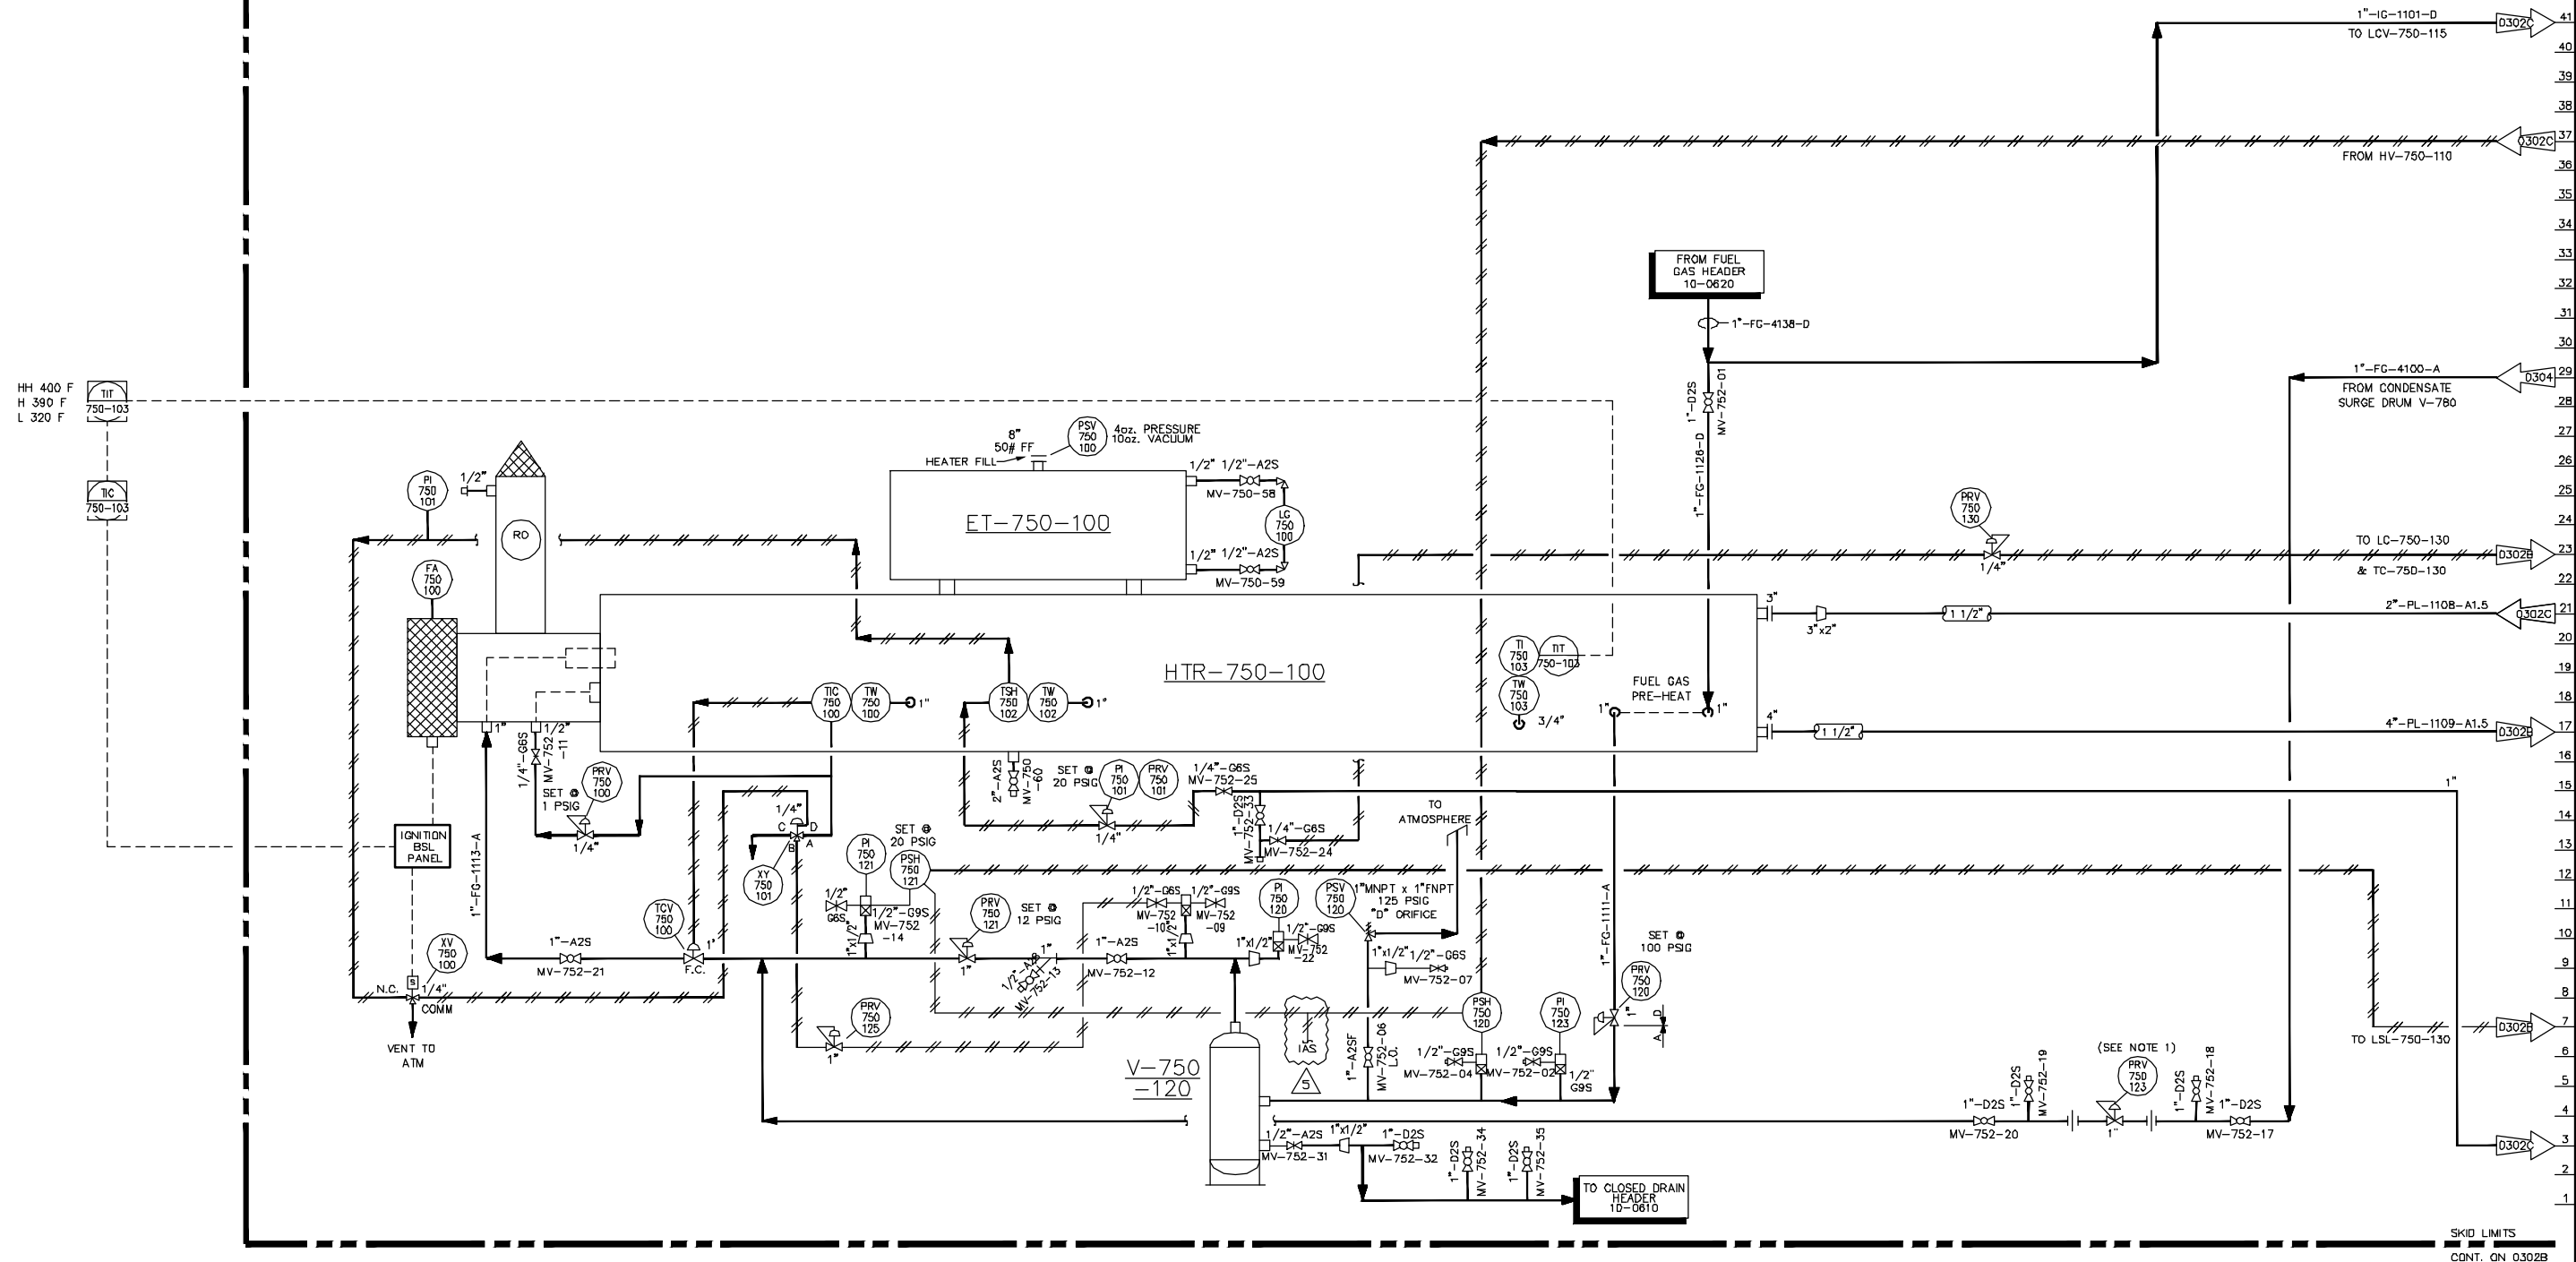

- NOTES:
1. FISHER 627 REGULATOR, 3/8" ORIFICE, 15-40 PSIG RANGE, SET @ 20 PSIG MAX.
2. AUDUBON ENGINEERING DRAFTED THIS P&ID BASED ON EXTERAN P&ID # HANO-481041000-00 REV. 0.



PITTSBURGH - PHILADELPHIA - CHICAGO - DETROIT - ST. LOUIS - HOUSTON

PROJECT PIT.22.7136


LAST EDIT: 10 Apr 24 2:28PM MJV-CGP-10-0302A-R5.dwg

REV.	DESCRIPTION	BY	CHK'D	APP'D	DATE	DRAWN	DATE
5	AS-BUILT REDLINES	KBK	RCA	JMM	04/12/24		
4	REVISED PER PHA REDLINES	RCA	KBK	JMM	09/02/22		
3	AS-BUILT FOR PHA	RCA	KBK	JMM	04/01/22		
2	AS-BUILT DRAWING	RG	KE	BS	2/15/16		
1	ISSUED FOR CONSTRUCTION	PH	JC	JD	03/11/14		
0	AS-BUILTS	PH	CC	JD	11/15/13		



MARCELLUS SHALE DEVELOPMENT
MAJORSVILLE CGP
PIPING & INSTRUMENTATION DIAGRAM
CONDENSATE STABILIZER (REBOILER)

JOB NO. D09963-001 DWG. NO. MJV-CGP-10-0302A

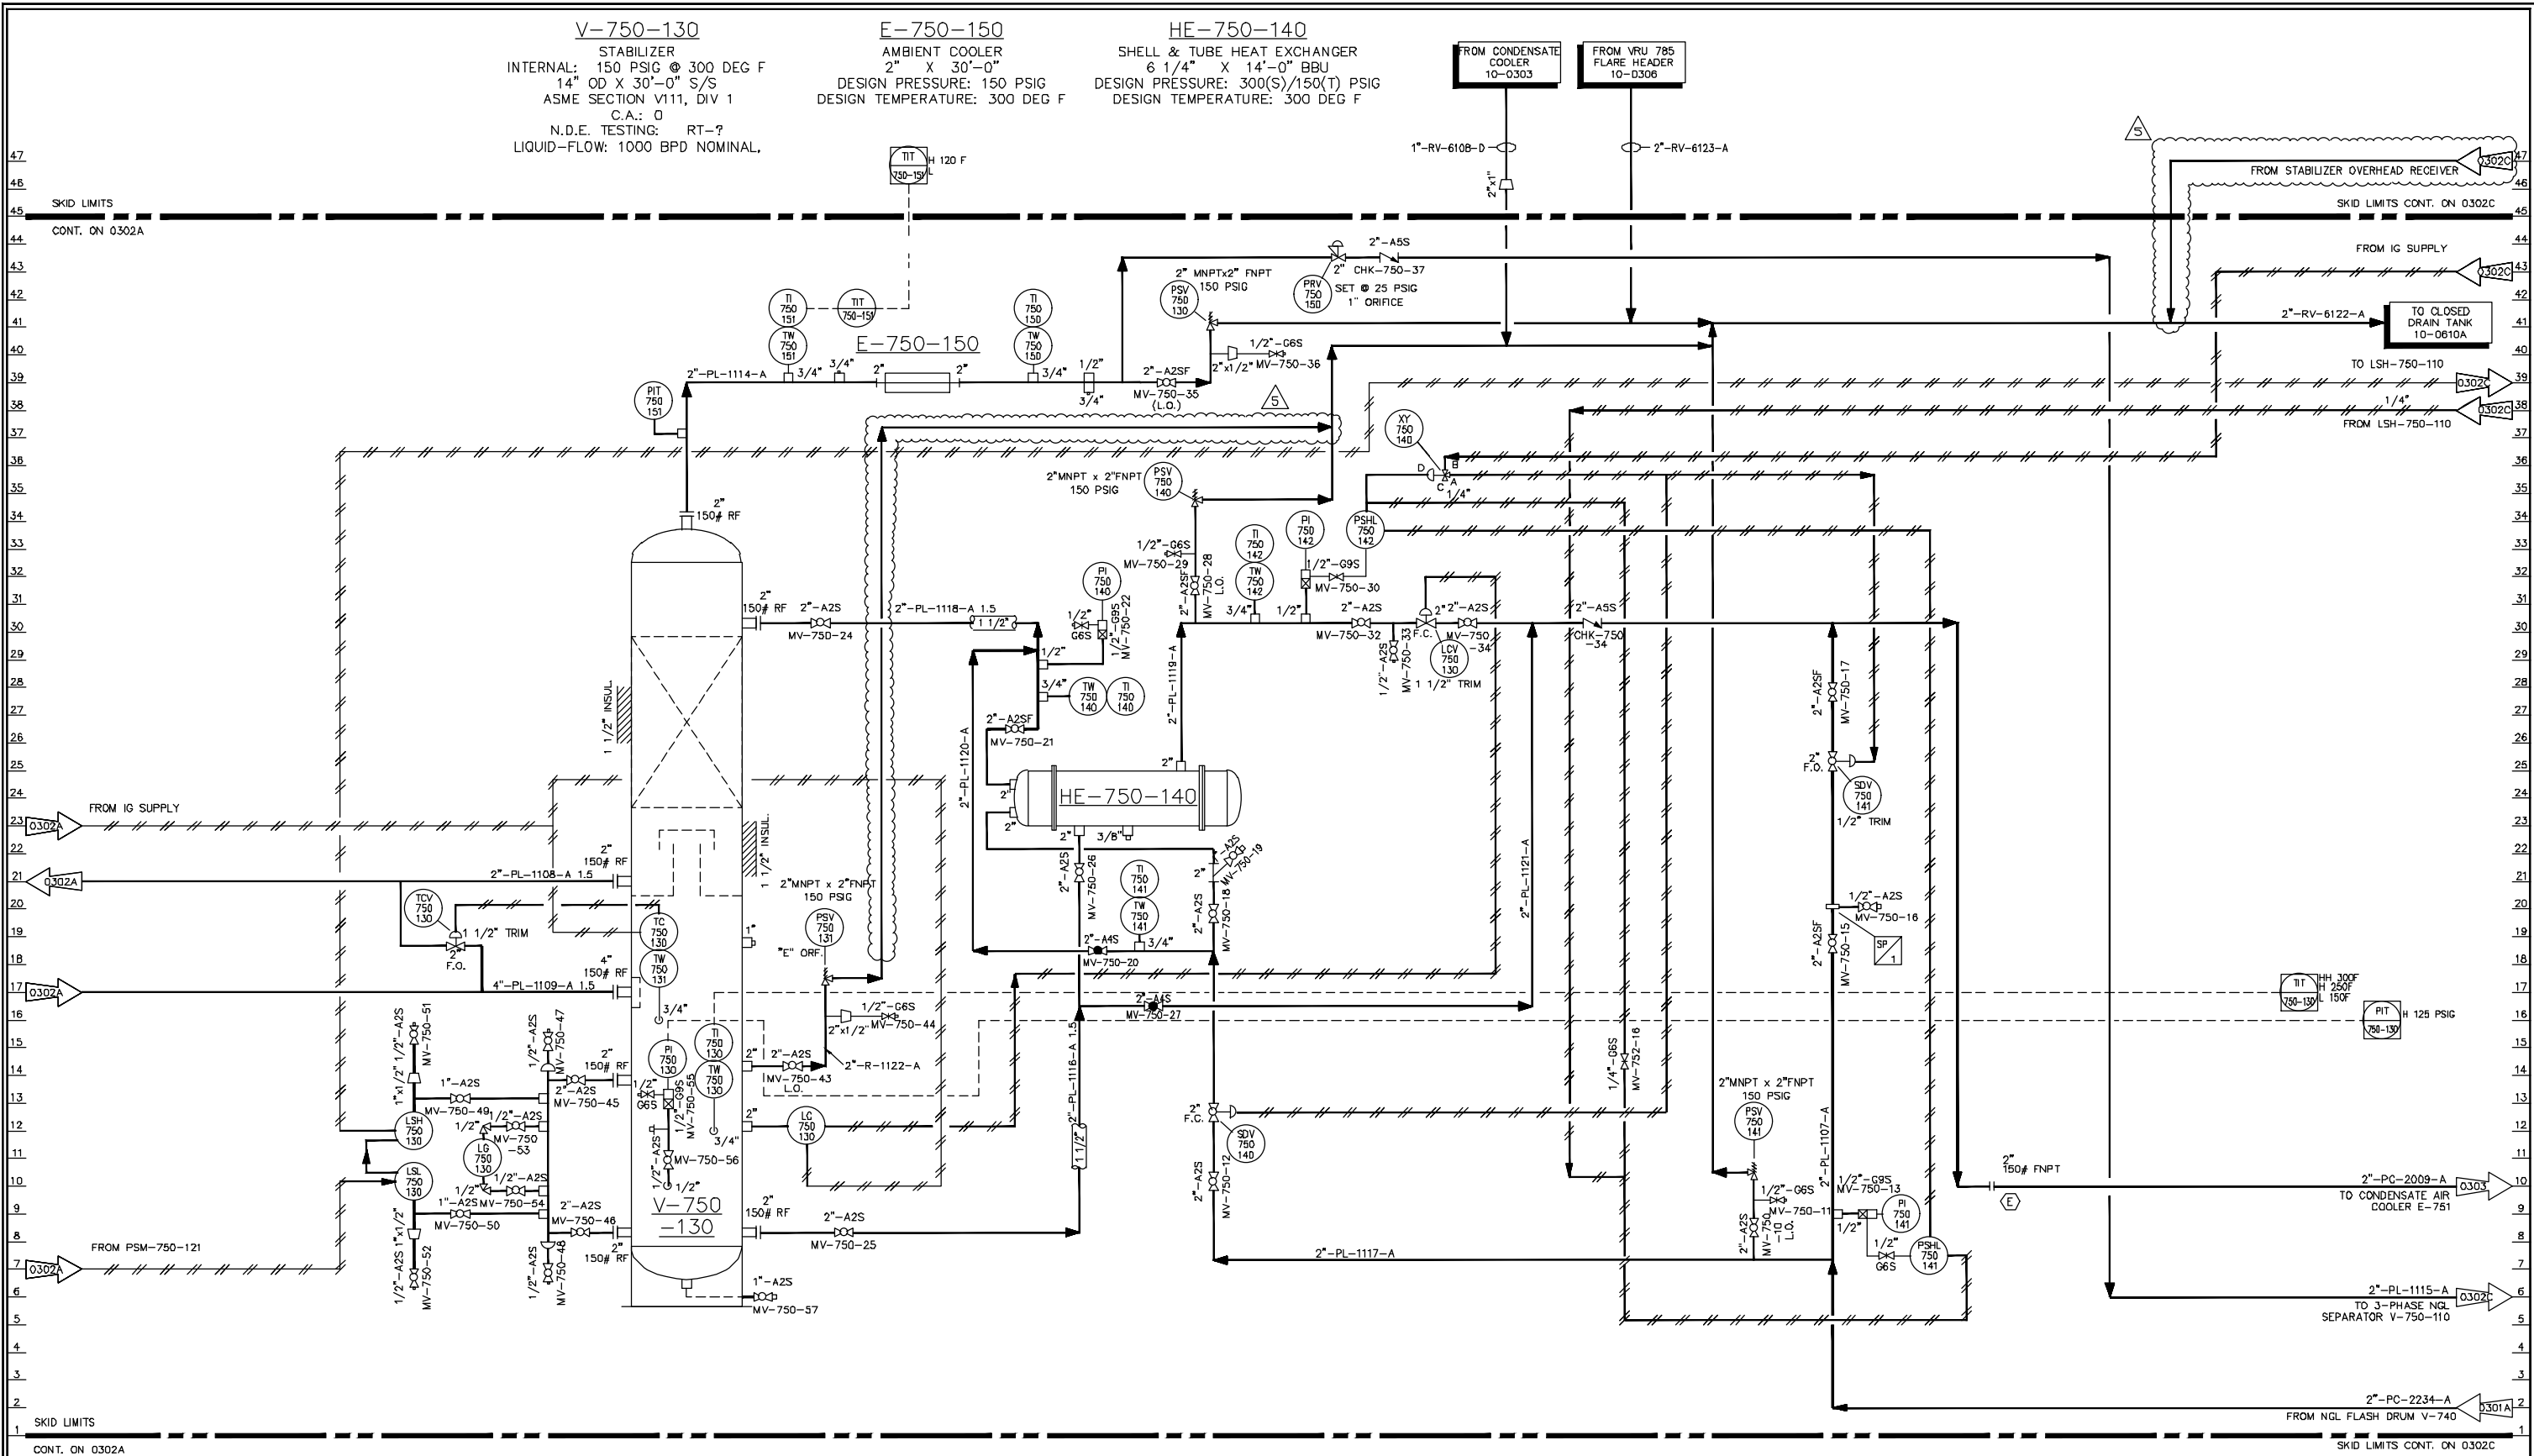

NOTES:

1. CONDENSATE STABILIZER 750 ACTS AS BACKUP TO CONDENSATE STABILIZER 745. STARTUP PROVISIONS ARE REQUIRED. MINIMUM FLOW IS 500 BPD.



PITTSBURGH - PHILADELPHIA - CHICAGO - DETROIT - ST. LOUIS - HOUSTON

PROJECT PIT.22.7136

LAST EDIT: 10 Apr 24 2:29PM MJV-CGP-10-0302B-R5.dwg

REV.	DESCRIPTION	BY	CHK'D	APP'D	DATE	DRAWN	CHECKED	DATE
5	AS-BUILT REDLINES	KBK	RCA	JMM	04/12/24			
4	REVISED PER PHA REDLINES	RCA	KBK	JMM	09/02/22			
3	AS-BUILT FOR PHA	RCA	KBK	JMM	04/01/22			
2	AS-BUILT DRAWING	RG	KE	BS	2/16/16			
1	ISSUED FOR CONSTRUCTION	PH	JD	JD	03/11/14			
0	AS-BUILTS	PH	CC	JD	11/15/13			




MARCELLUS SHALE DEVELOPMENT
MAJORSVILLE CGP
PIPING & INSTRUMENTATION DIAGRAM
CONDENSATE STABILIZER (TOWER)

JOB NO. 009963-001 DWG. NO. MJV-CGP-10-0302B

V-750-110
3-PHASE NGL SEPARATOR
INTERNAL: 125 PSIG @ 1300 DEG F/-20 DEG F
24" OD X 7'-6" S/S
ASME SECTION V111, DIV 1
C.A.: 0
N.D.E. TESTING: RT-?

V-750-115
BLOWCASE
INTERNAL: 1440 PSIG @ 300 DEG F
24" OD X 5'-0" S/S
ASME SECTION V111, DIV 1
C.A.: 0
N.D.E. TESTING: RT-1

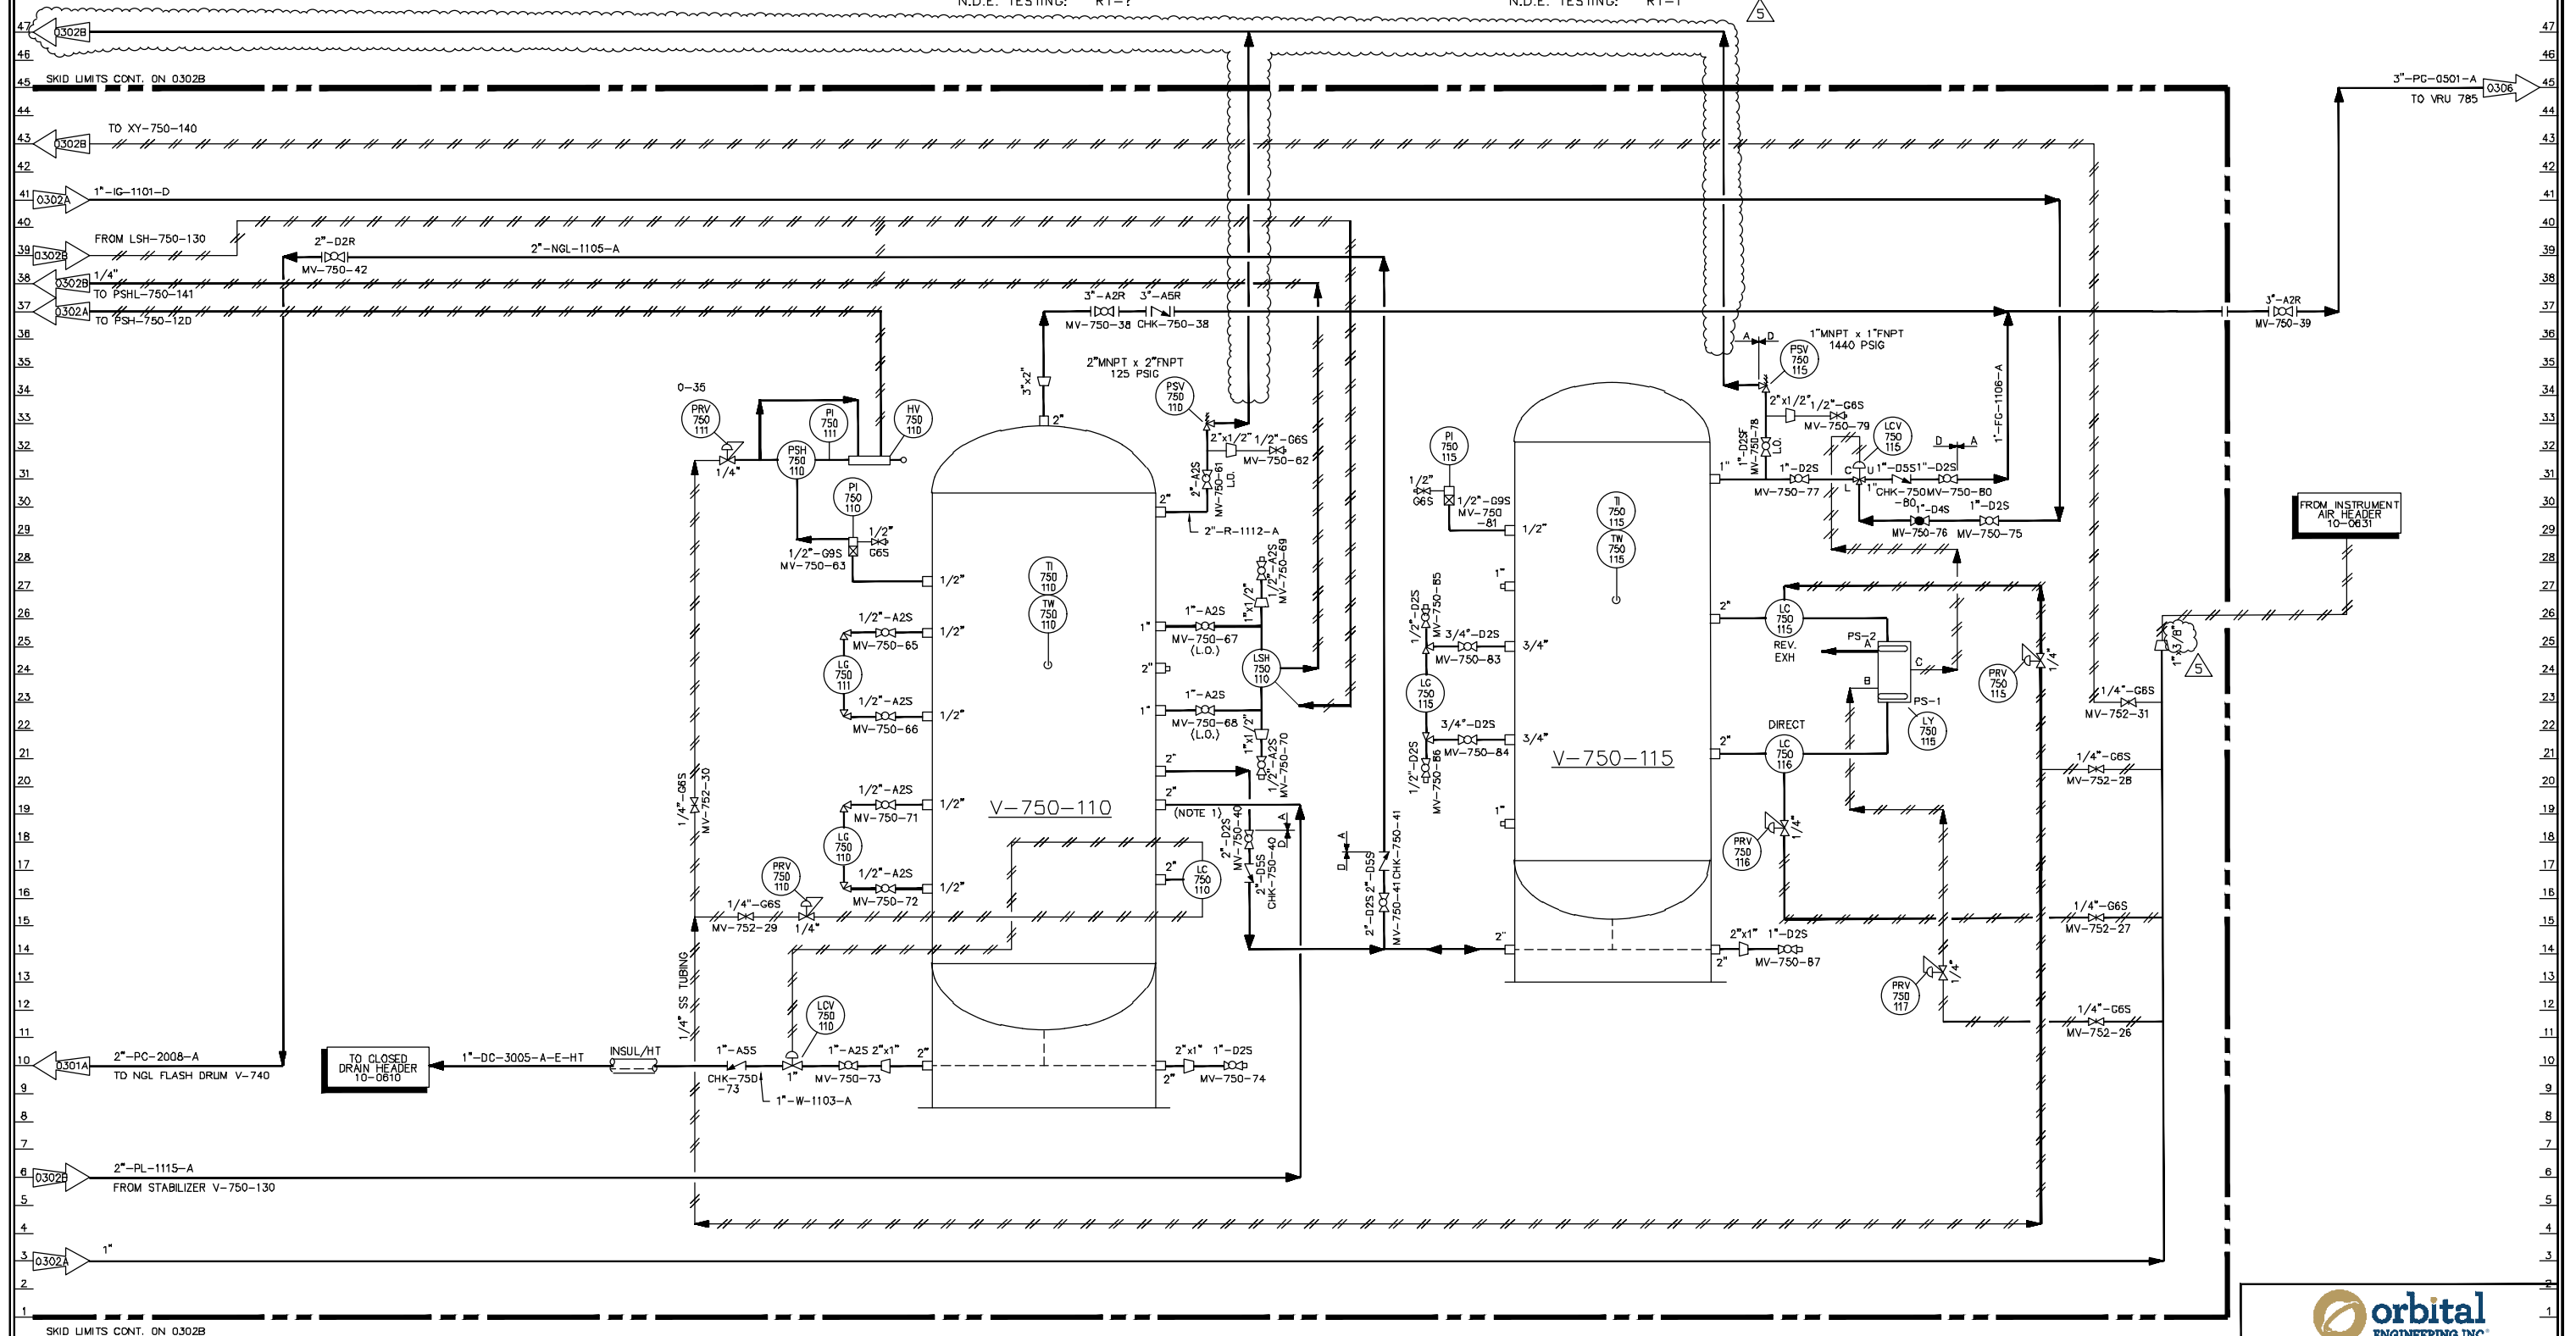

NOTES:
1. GRAVITY FLOW

REV.	DESCRIPTION	BY	CHK'D	APP'D	DATE	DRAWN	LAF	02/09/12	JOB NO.	009963.001	DWG. NO.	MJV-CGP-10-0302C
5	AS-BUILT REDLINES	KBK	RCA	JMM	04/12/24							
4	REVISED PER PHA REDLINES	RCA	KBK	JMM	09/02/22							
3	AS-BUILT FOR PHA	RCA	KBK	JMM	04/01/22							
2	AS-BUILT DRAWING	RG	KE	BS	2/16/16							
1	ISSUED FOR CONSTRUCTION	PH	JC	JD	03/11/14							
0	CNX AS-BUILTS	PH	BS	AZ	06/21/13							





PROJECT PIT.22.7136



MARCELLUS SHALE DEVELOPMENT
MAJORSVILLE CGP
PIPING & INSTRUMENTATION DIAGRAM
STABILIZER OVERHEAD RECEIVER

E-751
CONDENSATE COOLER
DESIGN: 400 PSIG @ 300 F
MOTOR: 15 HP

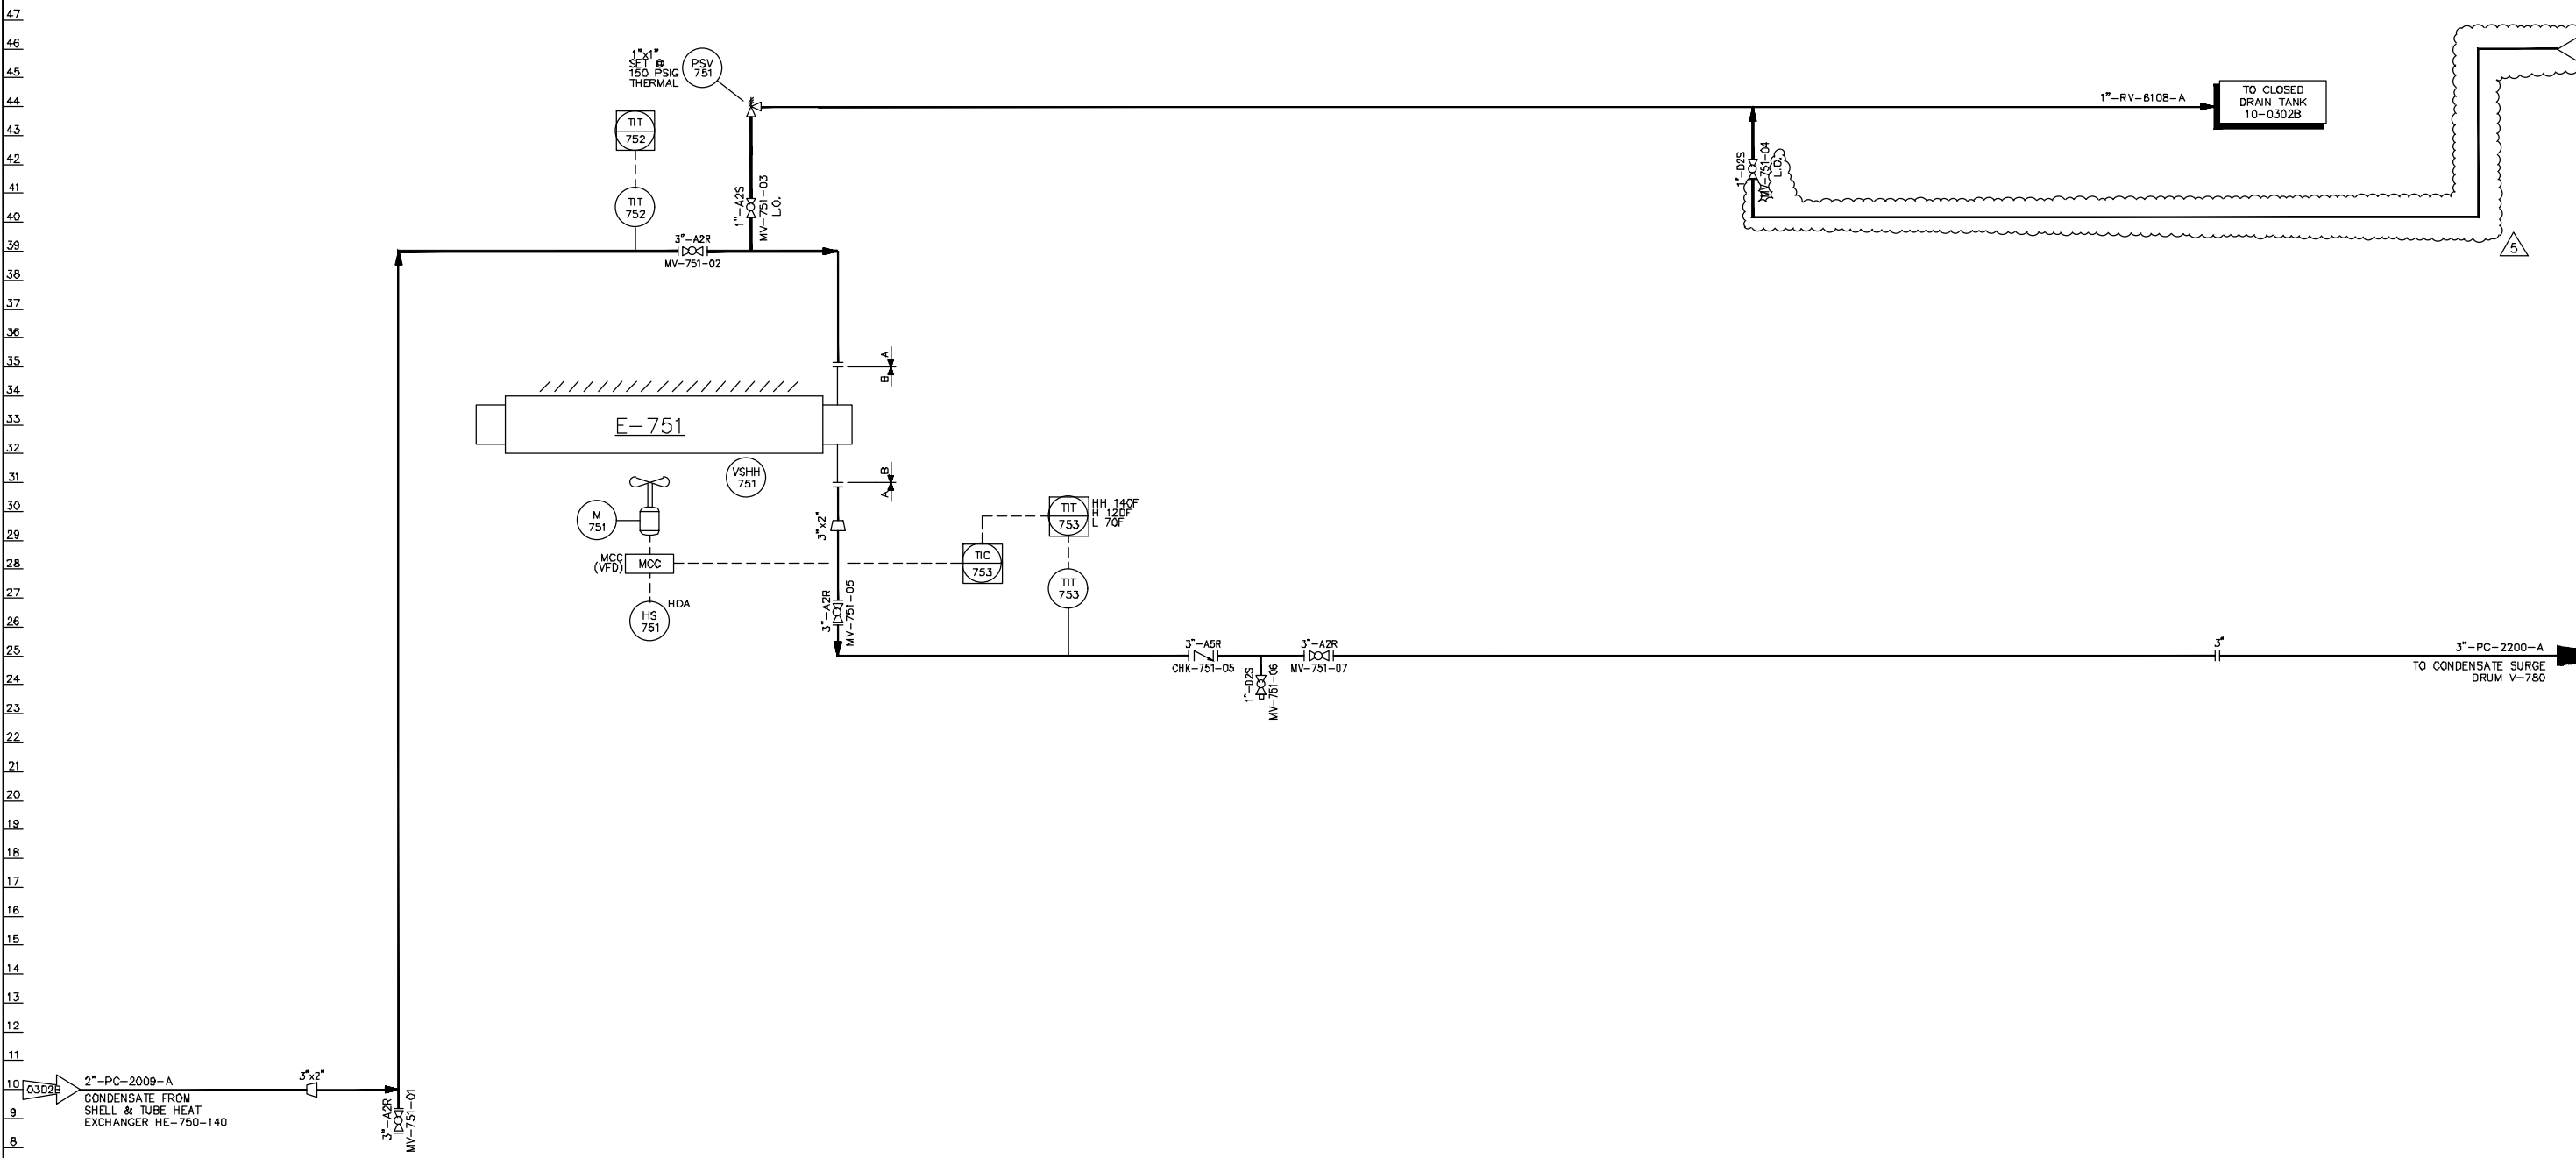

						 MARCELLUS SHALE DEVELOPMENT MAJORSVILLE CGP PIPING & INSTRUMENTATION DIAGRAM CONDENSATE COOLER						
5	AS-BUILT REDLINES	KBK	RCA	JMM	04/12/24							
4	AS-BUILT FOR PHA	RCA	KBK	JMM	04/01/22							
3	AS-BUILT	CNH	KRE	BMS	08/24/15							
2	ISSUED FOR CONSTRUCTION	PH	JC	JD	03/11/14	CLIENT	-	-				
1	AS-BUILTS	PH	CC	JD	11/15/13	APPROVED	-	-				
0	CNX AS-BUILTS	PH	BS	AZ	06/21/13	CHECKED	-	-				
REV.	DESCRIPTION	BY	CHK'D	APP'D	DATE	DRAWN	LAF	02/09/12	JOB NO.	009963.001	DWG. NO.	MJV-CGP-10-0303



ENGINEERING, INC.
PITTSBURGH - PHILADELPHIA - CHICAGO - DETROIT - ST. LOUIS - HOUSTON

PROJECT PIT.22.7136



MARCELLUS SHALE DEVELOPMENT
MAJORSVILLE CGP
PIPING & INSTRUMENTATION DIAGRAM
CONDENSATE COOLER


CONDENSATE EXPORT SKID

V-780
CONDENSATE SURGE DRUM

SIZE: 42" I.D. x 16'-0" S/S
DESIGN PRESSURE: 900 PSIG @ 150°F/-20°F
DESIGN PRESSURE: 0 PSIA @ 300°F
OPERATING PRESSURE: 25 PSIG @ 115°F
CAPACITY: 1,000 GALLONS

P-781
CONDENSATE BOOSTER PUMPS

DESIGN PRESSURE: 232 PSIG @ 392°F
OPERATING PRESSURE (S/D): 8.4 PSIG/20.4 PSIG
OPERATING TEMPERATURE: 115°F
CAPACITY: 30 GPM
MOTOR: 3.0 HP
(2 x 100%)

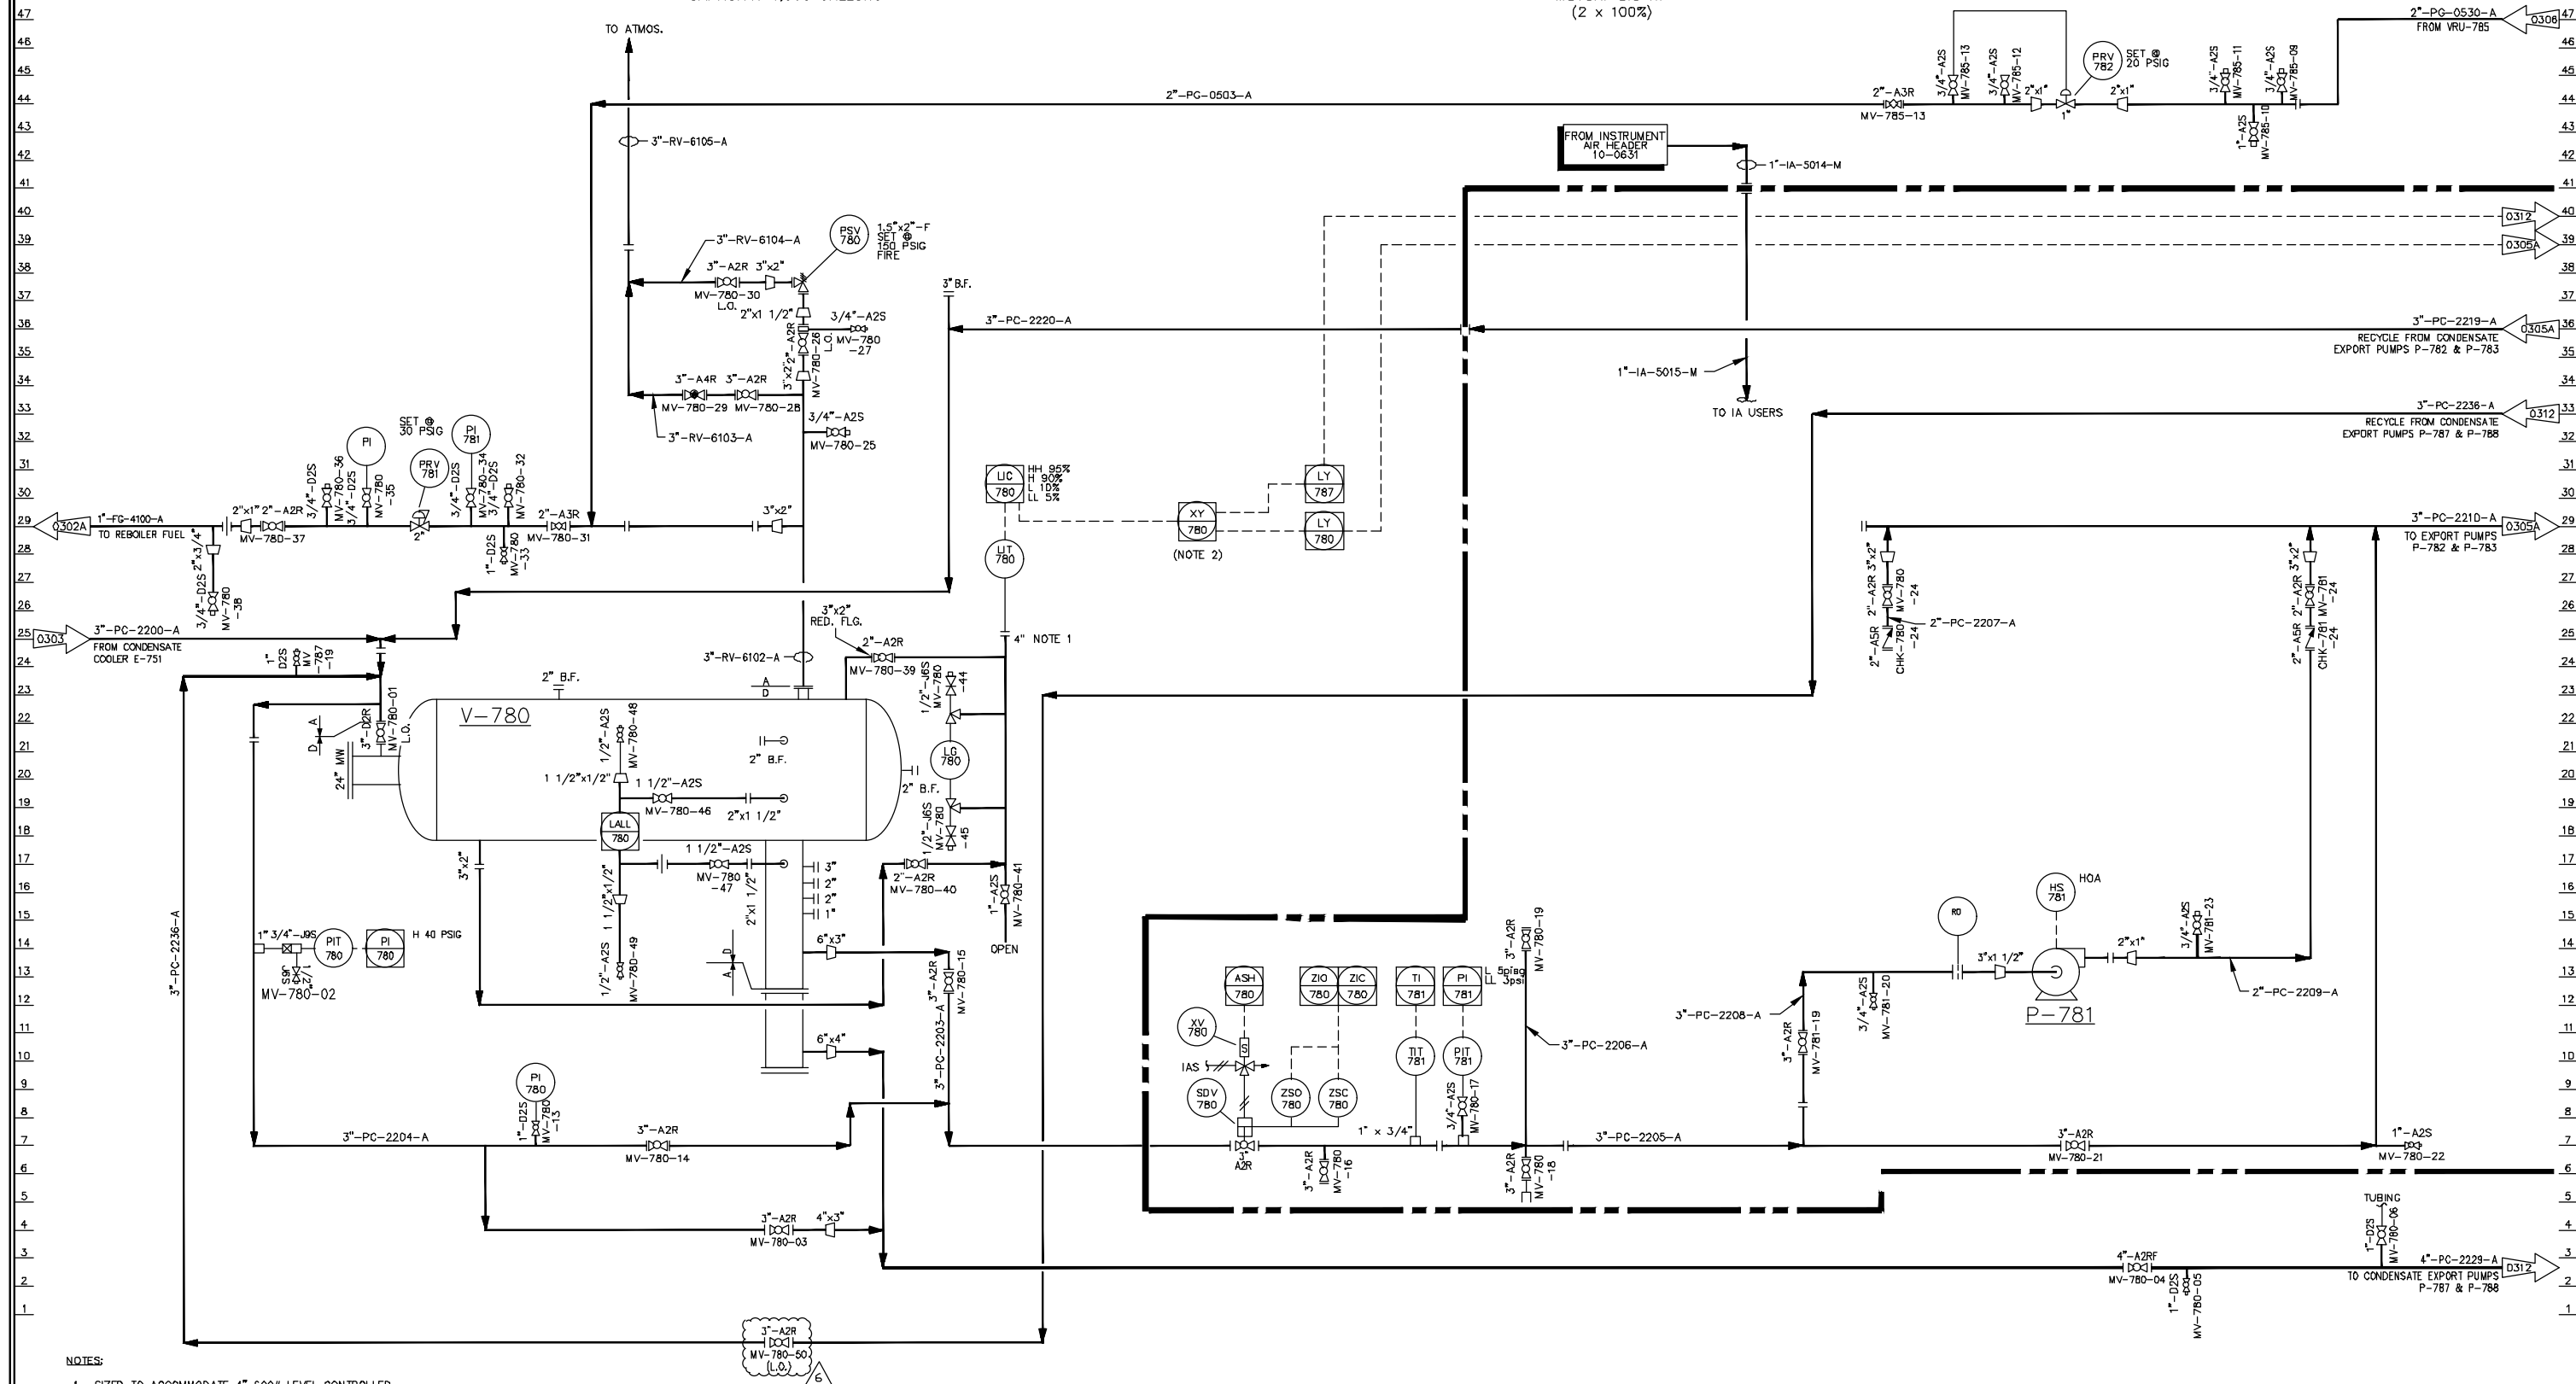

NOTES:

1. SIZED TO ACCOMMODATE 4" 600# LEVEL CONTROLLER.
2. XY-780 IS DESIGNED TO ALLOW THE OUTPUT OF LIC-780 TO BE SWITCHED TO EITHER LY-780 OR LY-787 DEPENDING ON THE PUMPS IN SERVICE.



PITTSBURGH - PHILADELPHIA - CHICAGO - DETROIT - ST. LOUIS - HOUSTON

PROJECT PIT.22.7136

LAST EDIT: 23 Mar 23 10:47AM MJV-CGP-10-0304-RB.dwg

REV.	DESCRIPTION	BY	CHK'D	APP'D	DATE	DRAWN	LAF	02/09/12	JOB NO.	009963.001	DWG. NO.	MJV-CGP-10-0304
6	REVISED PER PHA REDLINES	RCA	KBK	JMM	09/02/22							
5	AS-BUILT FOR PHA	RCA	KBK	JMM	04/01/22							
4	AS-BUILT	CNH	KRE	BMS	08/25/15							
3	REV FOR MOC 09242014	KJR	KC	CB	04/08/15							
2	ISSUED FOR CONSTRUCTION	PH	JC	JD	03/11/14							
1	ISSUED FOR CONSTRUCTION - VRU & TANKS	SS	CG	JD	11/07/13							
0	CNX AS-BUILTS	PH	BS	AZ	06/21/13							



MARCELLUS SHALE DEVELOPMENT
MAJORSVILLE CGP
PIPING & INSTRUMENTATION DIAGRAM
CONDENSATE SURGE DRUM &
CONDENSATE BOOSTER PUMPS

DESIGN PRESSURE: 1200 PSIG @ 250°F
DISCHARGE PRESSURE: 450 PSIG @ 120°F
CAPACITY: 30 GPM
MOTOR: 10 HP
(2 x 100%)



CLIENT	—	—
APPROVED	—	—
CHECKED	—	—
DRAWN	LAF	02/09/12

PROJECT PIT.22.7136

MARCELLUS SHALE DEVELOPMENT
MAJORSVILLE CGP
PIPING & INSTRUMENTATION DIAGRAM
CONDENSATE EXPORT PUMPS


JOB NO.	009963.001	DWG. NO.	MJV-CGP-10-0305A
---------	------------	----------	------------------

CONDENSATE MEASUREMENT SKID

ELITE MICROMOTION CORIOLIS METER
SIZE 2-INCH ANSI 600

BASKETT STRAINER
SIZE 3-INCH ANSI 600
MAWP = 1480 PSIG @ 100 DEGREES F
1480 PSIG @ 20 DEGREES F

KOMAX STATIC MIXER
SIZE 3-INCH ANSI 600

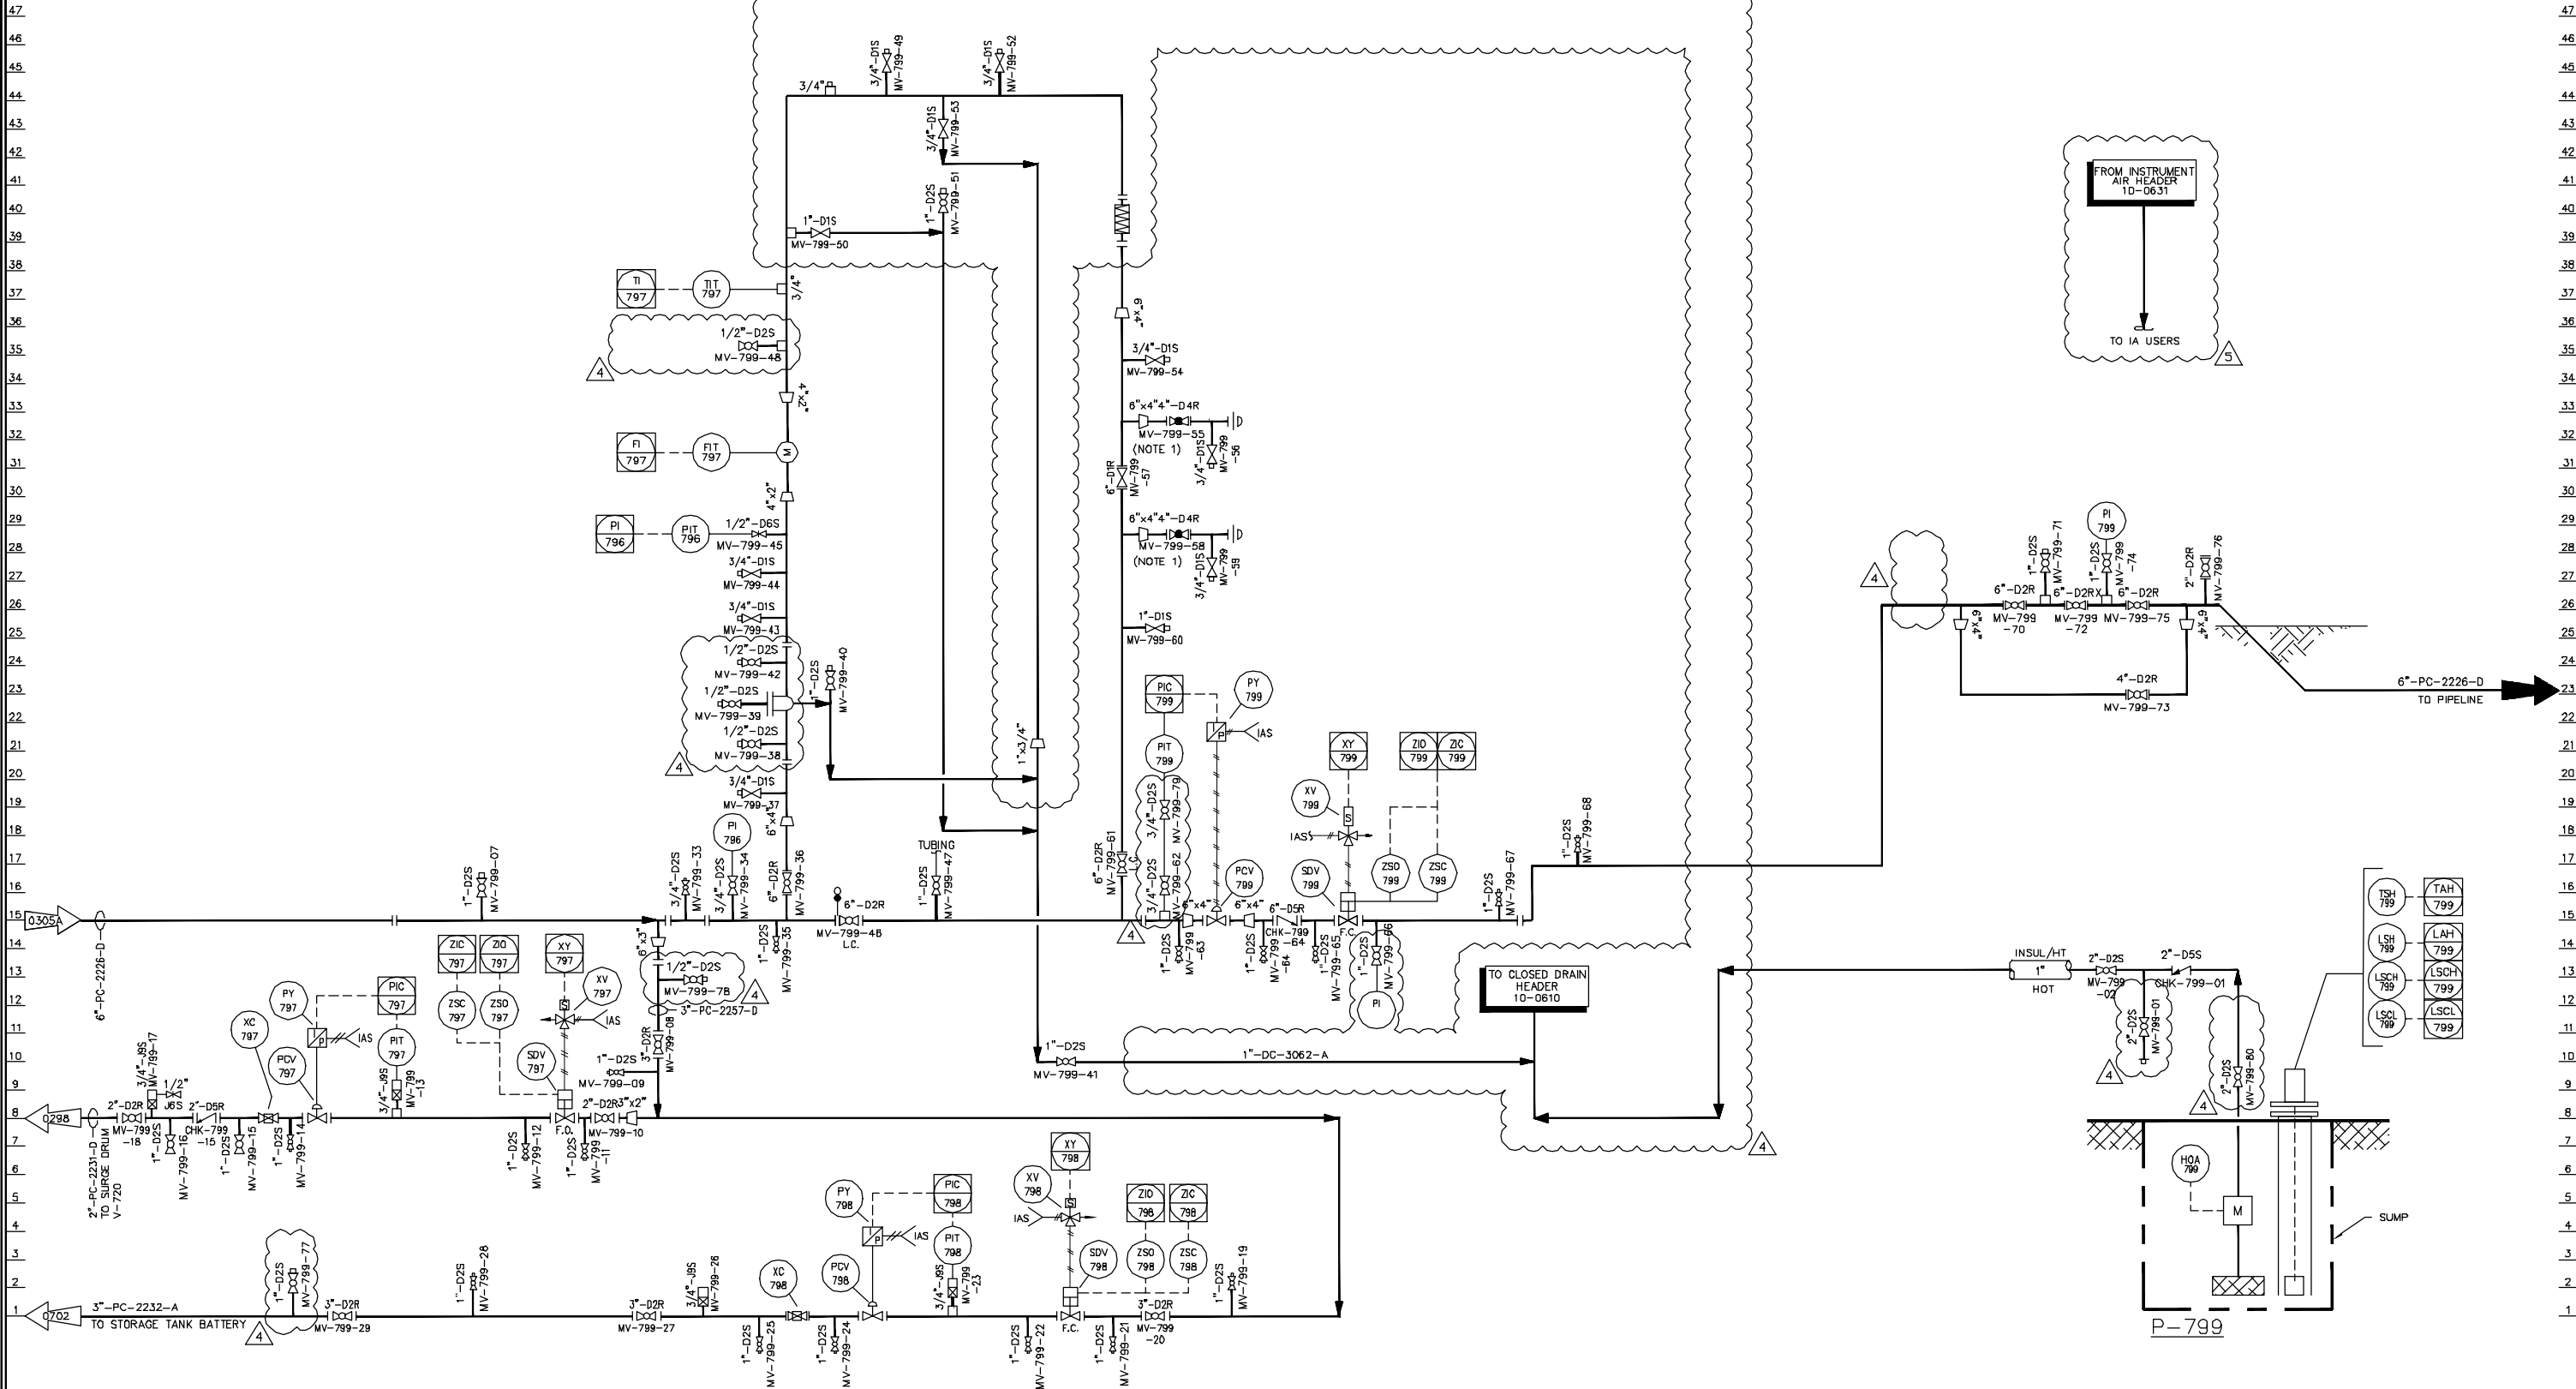

NOTES:

1. ORBIT VALVE.



PITTSBURGH - PHILADELPHIA - CHICAGO - DETROIT - ST. LOUIS - HOUSTON

PROJECT PIT.22.7136


REV.	DESCRIPTION	BY	CHK'D	APP'D	DATE	DRAWN	AD
4	AS-BUILT FOR PHA	RCA	KBK	JMM	04/01/22		
3	MOC #05172017	BMS	CB	BMS	7/12/17		
2	AS-BUILT DRAWING	RG	KE	BS	2/17/16		
1	REMOVED PRESSURE CONTROLLER SETPOINTS	SS	EH	JC	04/18/14		
0	ISSUED FOR CONSTRUCTION	PH	JC	JD	03/11/14		

CLIENT	—	—
APPROVED	JD	03/11/14
CHECKED	JC	03/11/14
DRAWN	AD	09/19/12



MARCELLUS SHALE DEVELOPMENT
MAJORSVILLE CGP
PIPING & INSTRUMENTATION DIAGRAM
CONDENSATE MEASUREMENT SKID

JOB NO. 009963.001 DWG. NO. MJV-CGP-10-0305B

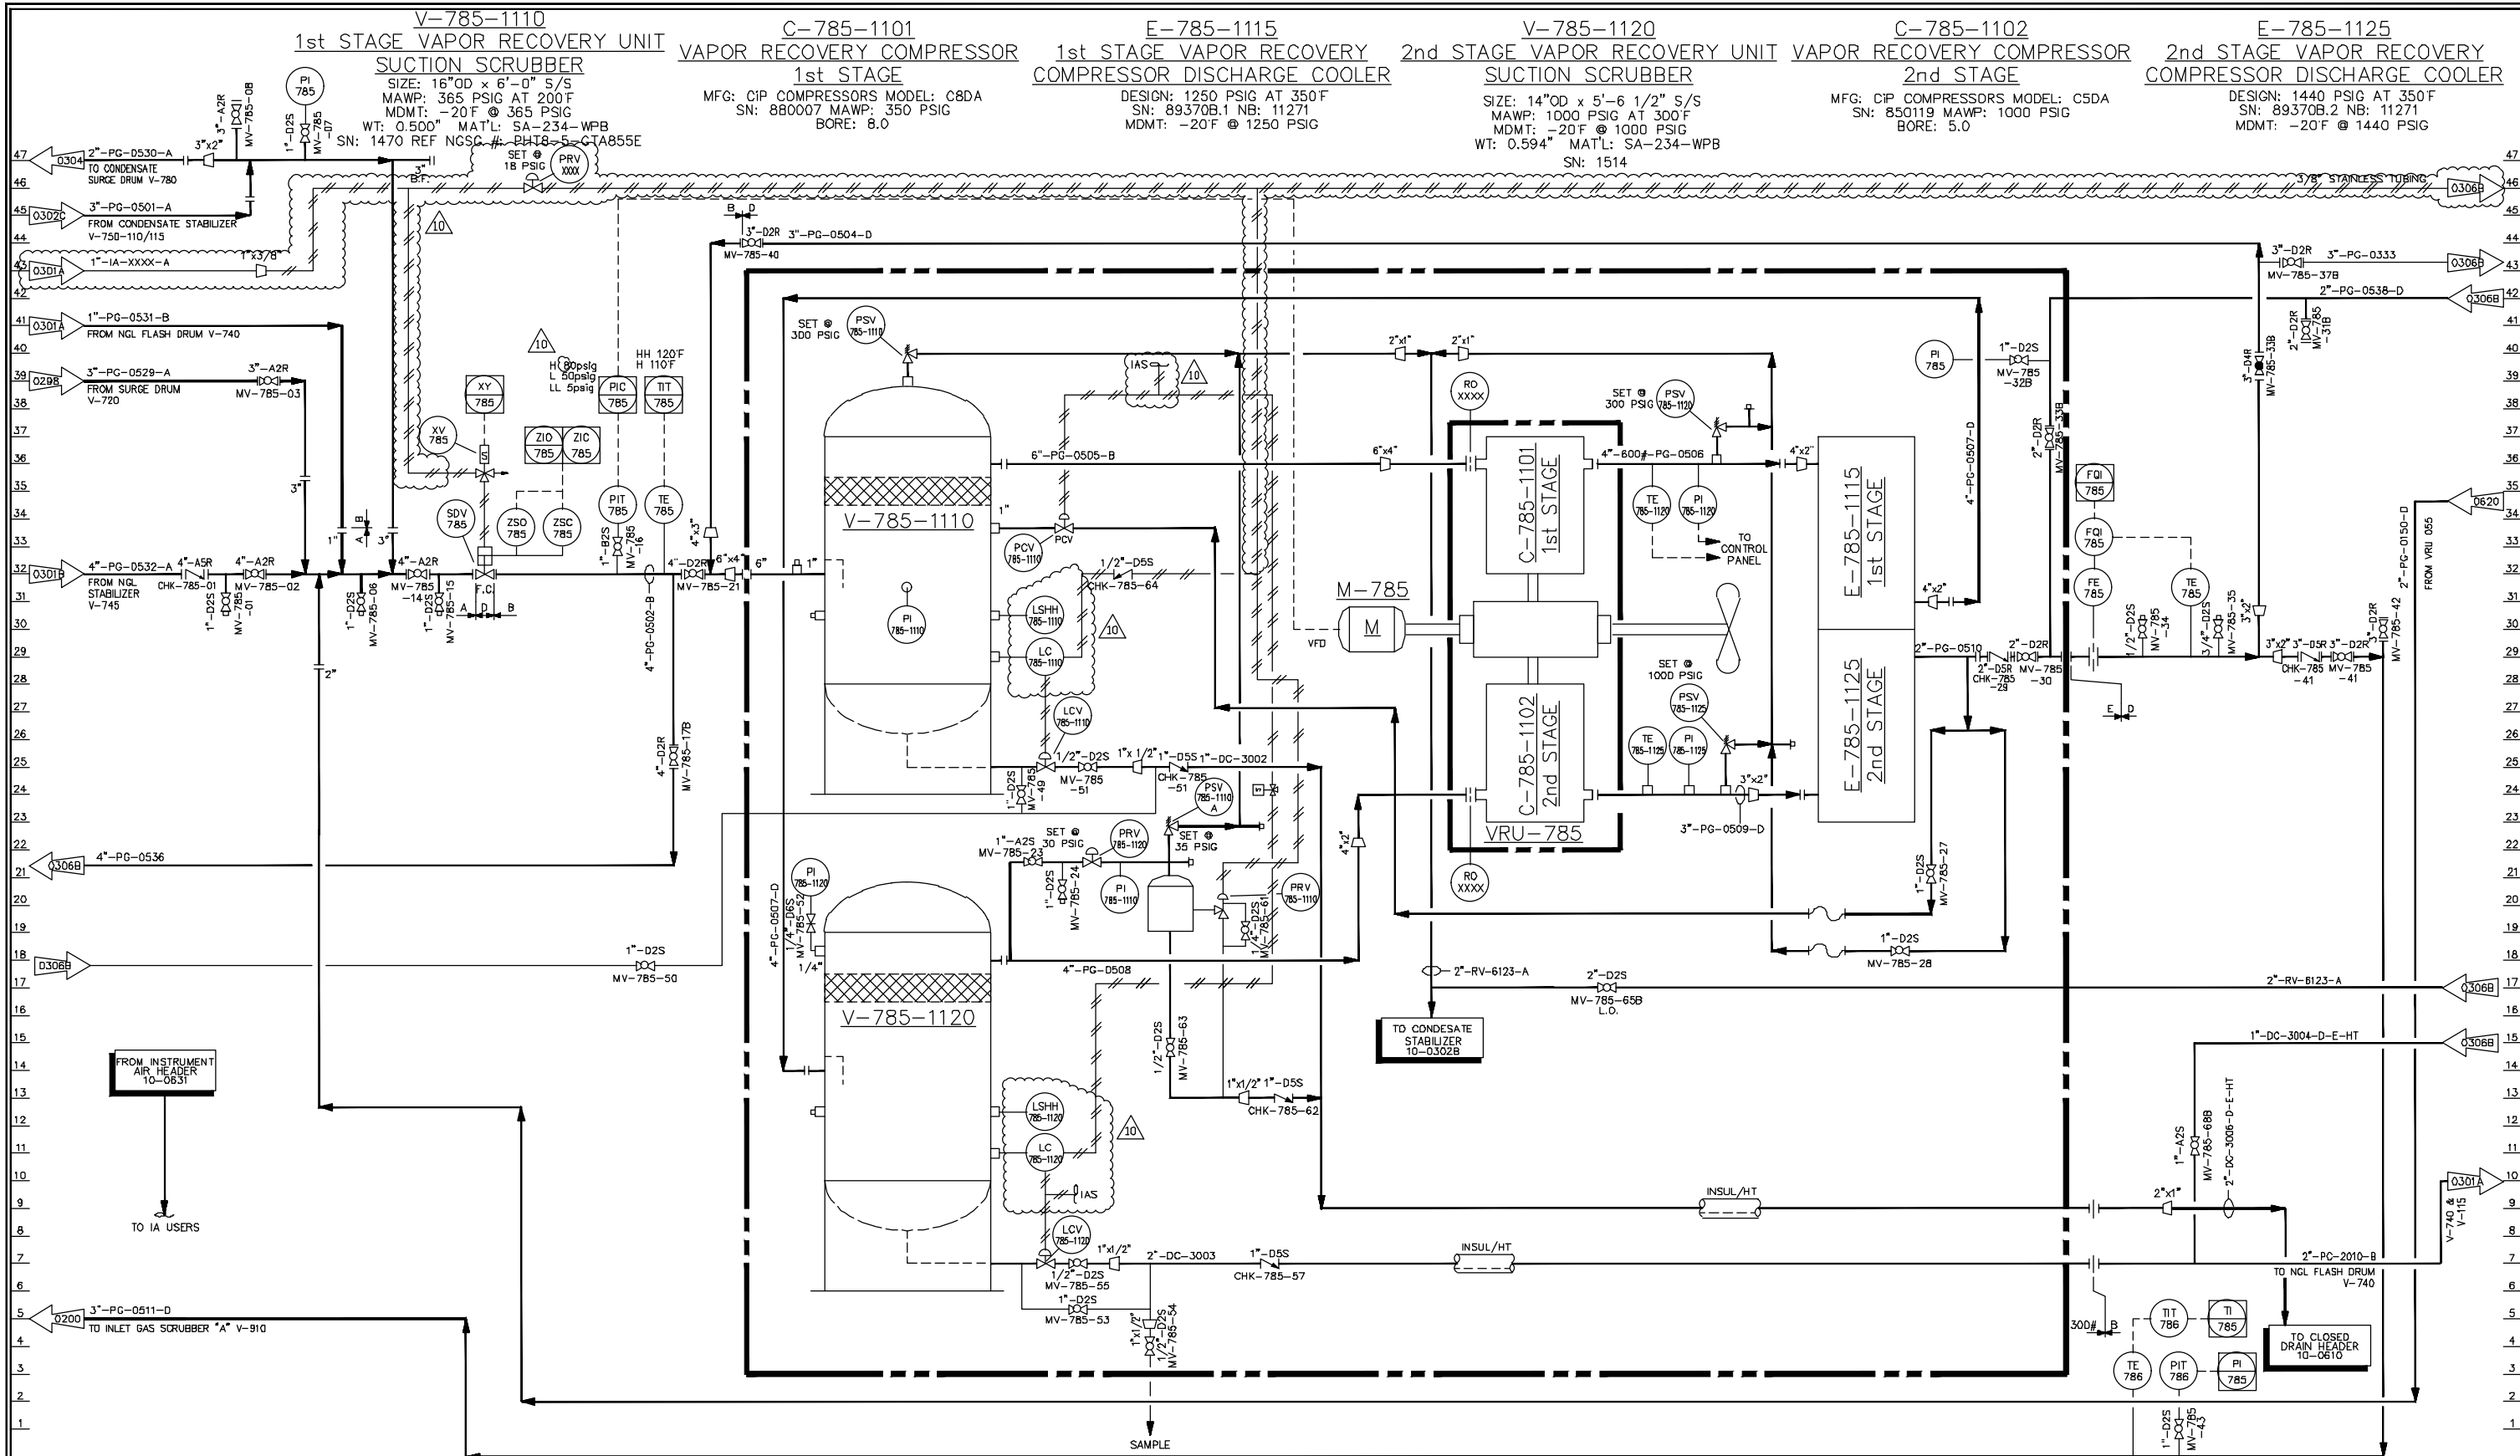

NOTES:

1. THESE INSTRUMENTS AND VALVES ARE SPECIFIED BY AEC AND PURCHASED BY CONSOL.



PITTSBURGH - PHILADELPHIA - CHICAGO - DETROIT - ST. LOUIS - HOUSTON

PROJECT PIT.22.7136

M-785
DRIVE MOTOR
MFG: BALDOR-RELIANCE 3-PHASE CONT. DUTY
150 HP; 165 AMP; 1785 RPM; 460 V; 60 Hz; SF=1.15
PF: 88.5; SN S9082690-001

V-785-1130
DAY TANK
CAPACITY: 30 GAL

VRU-785


10	AS-BUILT REDLINES	KBK	RCA	JMM	04/12/24
9	REVISED PER PHA REDLINES	RCA	KBK	JMM	08/02/22
8	AS-BUILT FOR PHA	RCA	KBK	JMM	04/01/22
7	ADDITION OF VRU-785C	BMS	CB	BMS	04/12/17
6	AS BUILTS	BMS	KE	BMS	11/10/15
5	REVISED FOR M.O.C. 07012015	KR	KC	CB	07/20/15
4	REVISED FOR M.O.C. 10012014	KR	KC	KC	04/06/15
3	AS BUILT	KK	BM	BS	04/01/15
2	ISSUED FOR CONSTRUCTION	PH	JC	JD	03/11/14
1	ISSUED FOR CONSTRUCTION - VRU & TANKS	SS	CC	JD	11/07/13
0	CNX AS-BUILTS	PH	BS	AZ	06/21/13
REV.	DESCRIPTION	BY	CHK'D	APP'D	DATE

CLIENT	-	-
APPROVED	-	-
CHECKED	-	-
DRAWN	LAF	02/09/12



MARCELLUS SHALE DEVELOPMENT
MAJORSVILLE CGP
PIPING & INSTRUMENTATION DIAGRAM
VAPOR RECOVERY UNIT

JOB NO. 009963.001 DWG. NO. MJV-CGP-10-0306

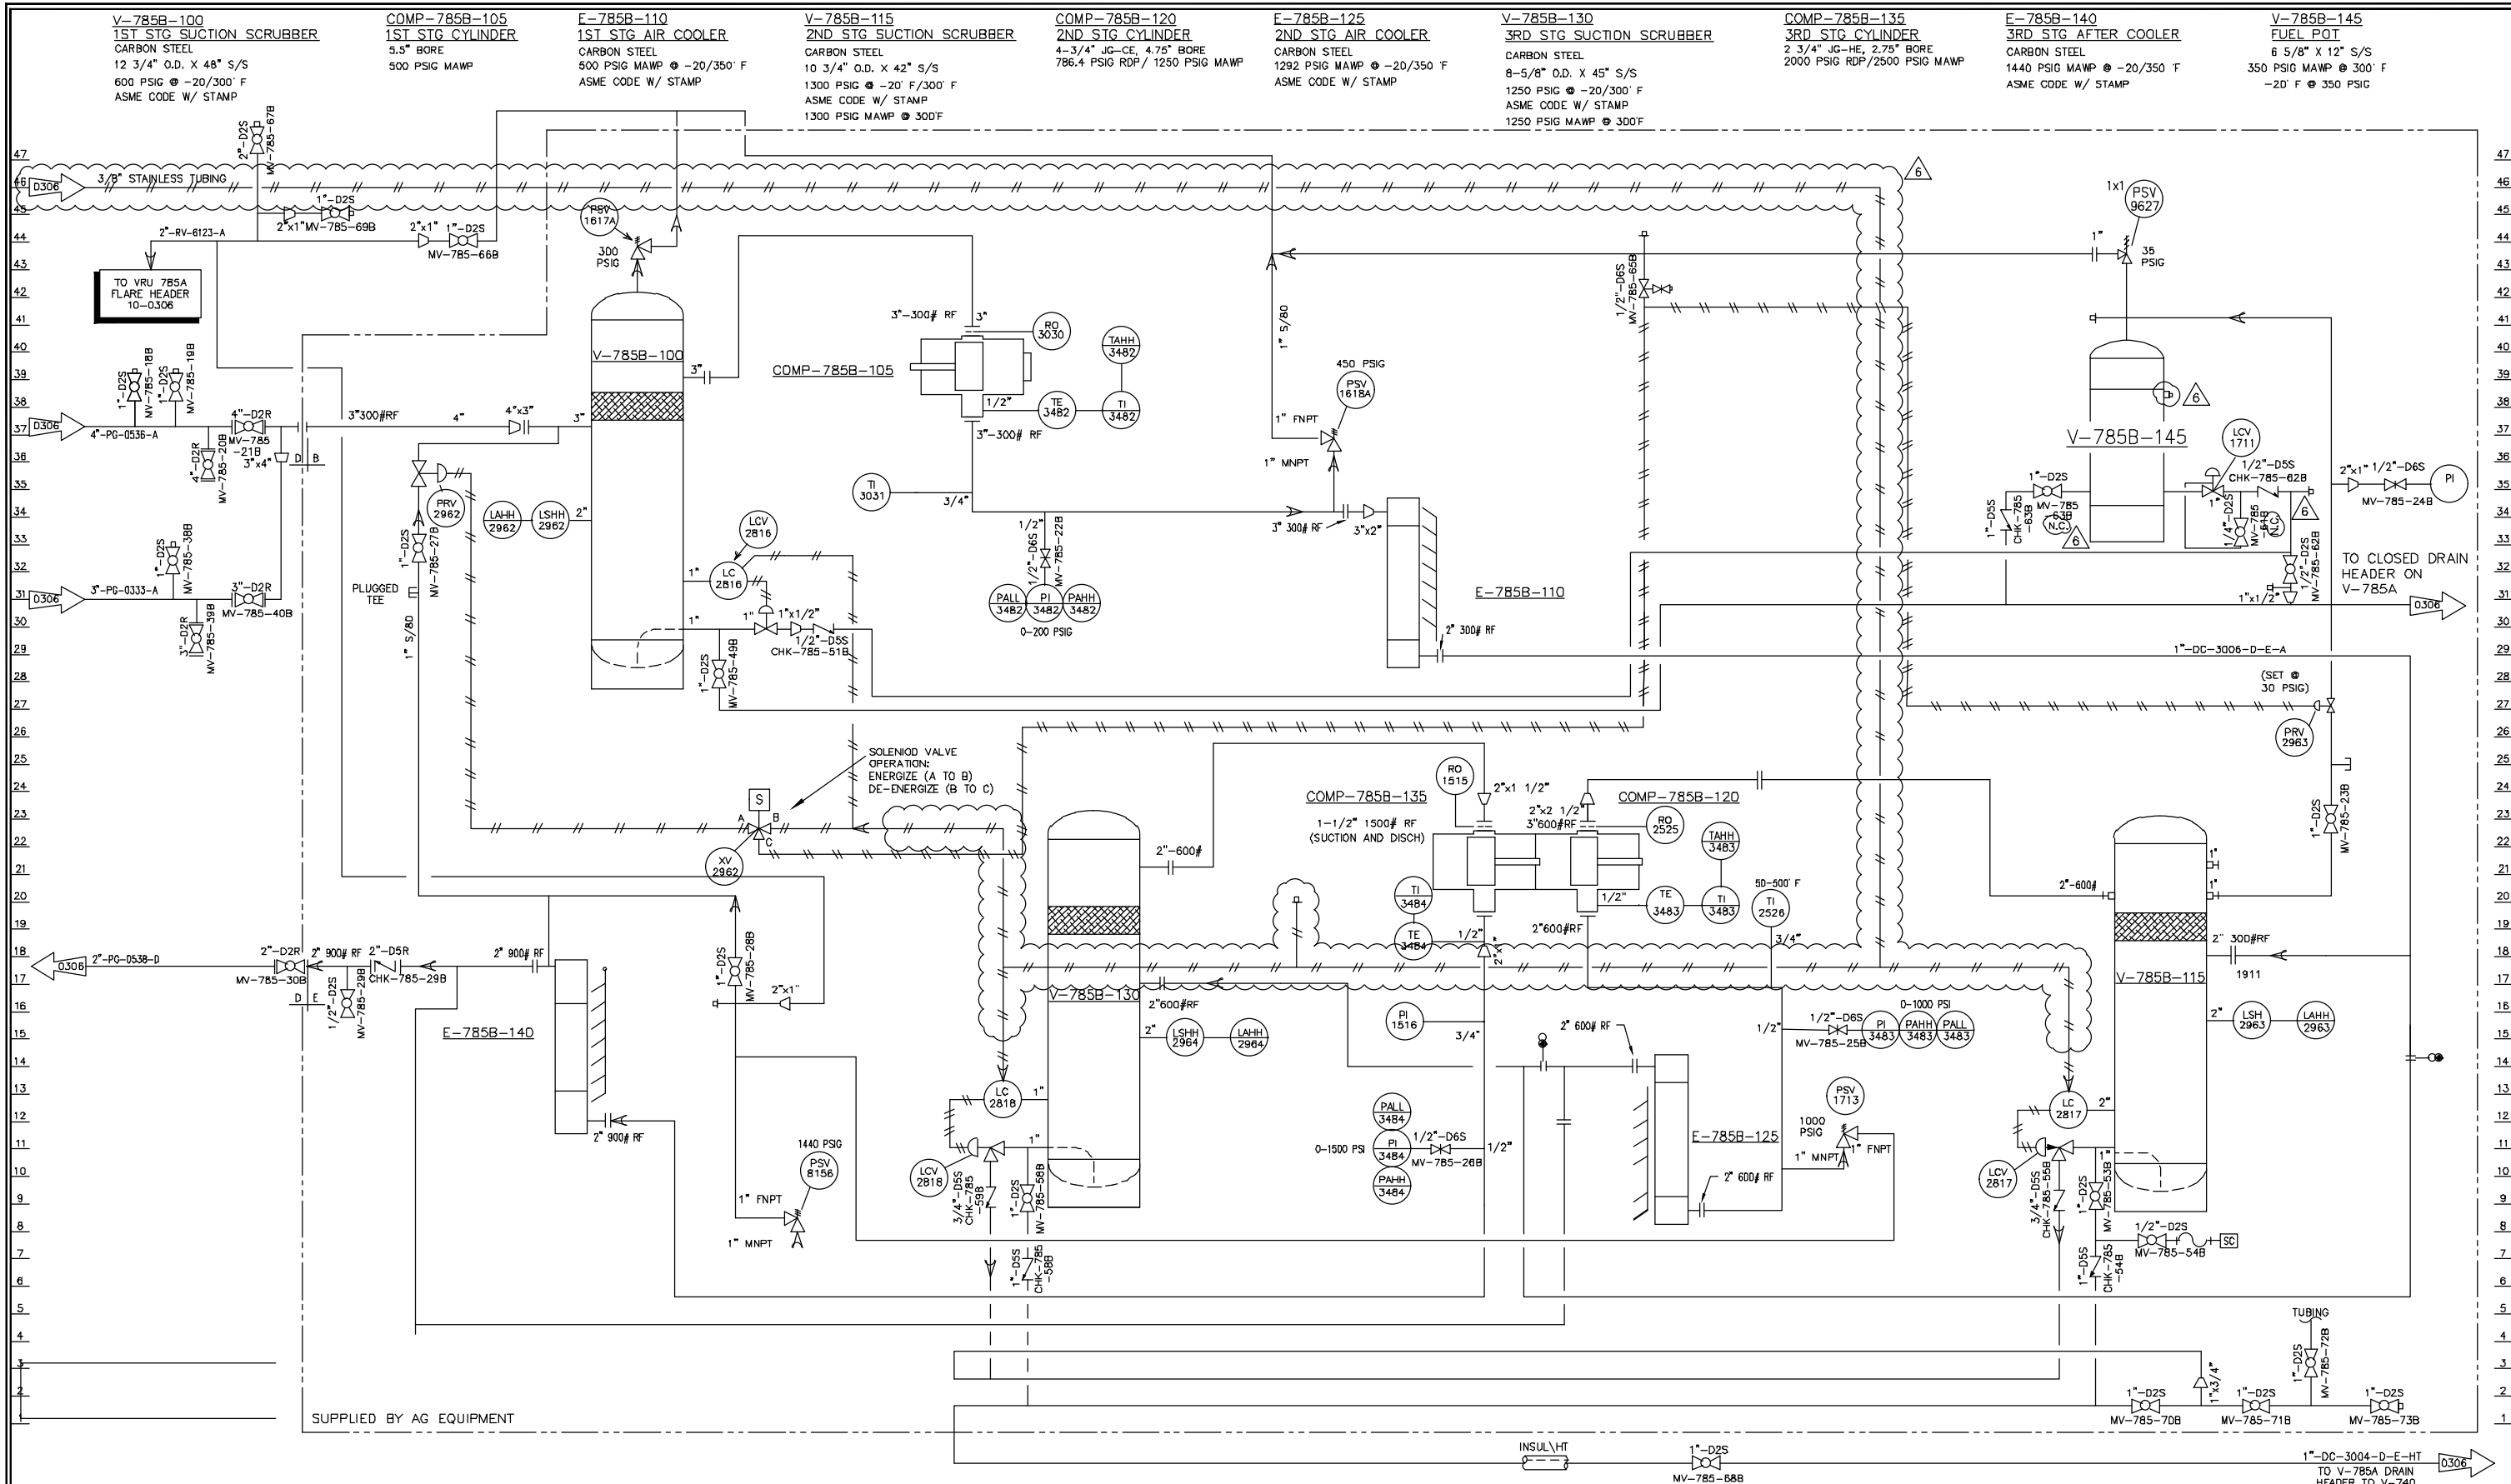

PITTSBURGH - PHILADELPHIA - CHICAGO - DETROIT - ST. LOUIS - HOUSTON

PROJECT PIT.22.7136

LAST EDIT: 10 Apr 24 3:51PM MJV-CGP-10-0306B-R6.dwg

REV.	DESCRIPTION	BY	CHK'D	APP'D	DATE	DRAWN	CHECKED	DATE
6	AS-BUILT REDLINES	KBK	RCA	JMM	04/12/24			
5	AS-BUILT FOR PHA	RCA	KBK	JMM	04/01/22			
4	ADDITION OF VRU-785C	BMS	CB	BMS	05/11/17			
3	AS-BUILTS	BMS	BMS	CB	09/07/16			
2	AS-BUILT	CNH	KRE	BMS	08/25/15			
1	REVISED FOR M.O.C. 10011214	KR	KC	KC	04/06/15			
0	AS BUILT	KK	BM	BS	04/01/15			



MARCELLUS SHALE DEVELOPMENT
MAJORSVILLE CGP
PIPING & INSTRUMENTATION DIAGRAM
VAPOR RECOVERY UNIT


JOB NO. 009963.001 DWG. NO. MJV-CGP-10-0306B



LAST EDIT: 23 Mar 23 11:53AM MJV-CGP-10-0306C-R1.dwg

																																																																																																																																																																																																																																																																																																																																																																																																																																																																																																																																																																																																																																																																																																																																																																																																																																																																																																																																																																																																																																																																																																																																																																																																																																																																																																																																																																																																																					</
--	--	----

P-787 & P-788
CONDENSATE EXPORT PUMPS No. 2
DESIGN (SUCTION): 150 PSIG @ 150' F
DESIGN (DISCHARGE): 721.5 PSIG @ 150' F
DISCHARGE PRESSURE: 485 PSIG
CAPACITY: 73 GPM
MOTOR: 40 HP
(2 x 100%)
Gould's Size 7ALC SN 314973-1

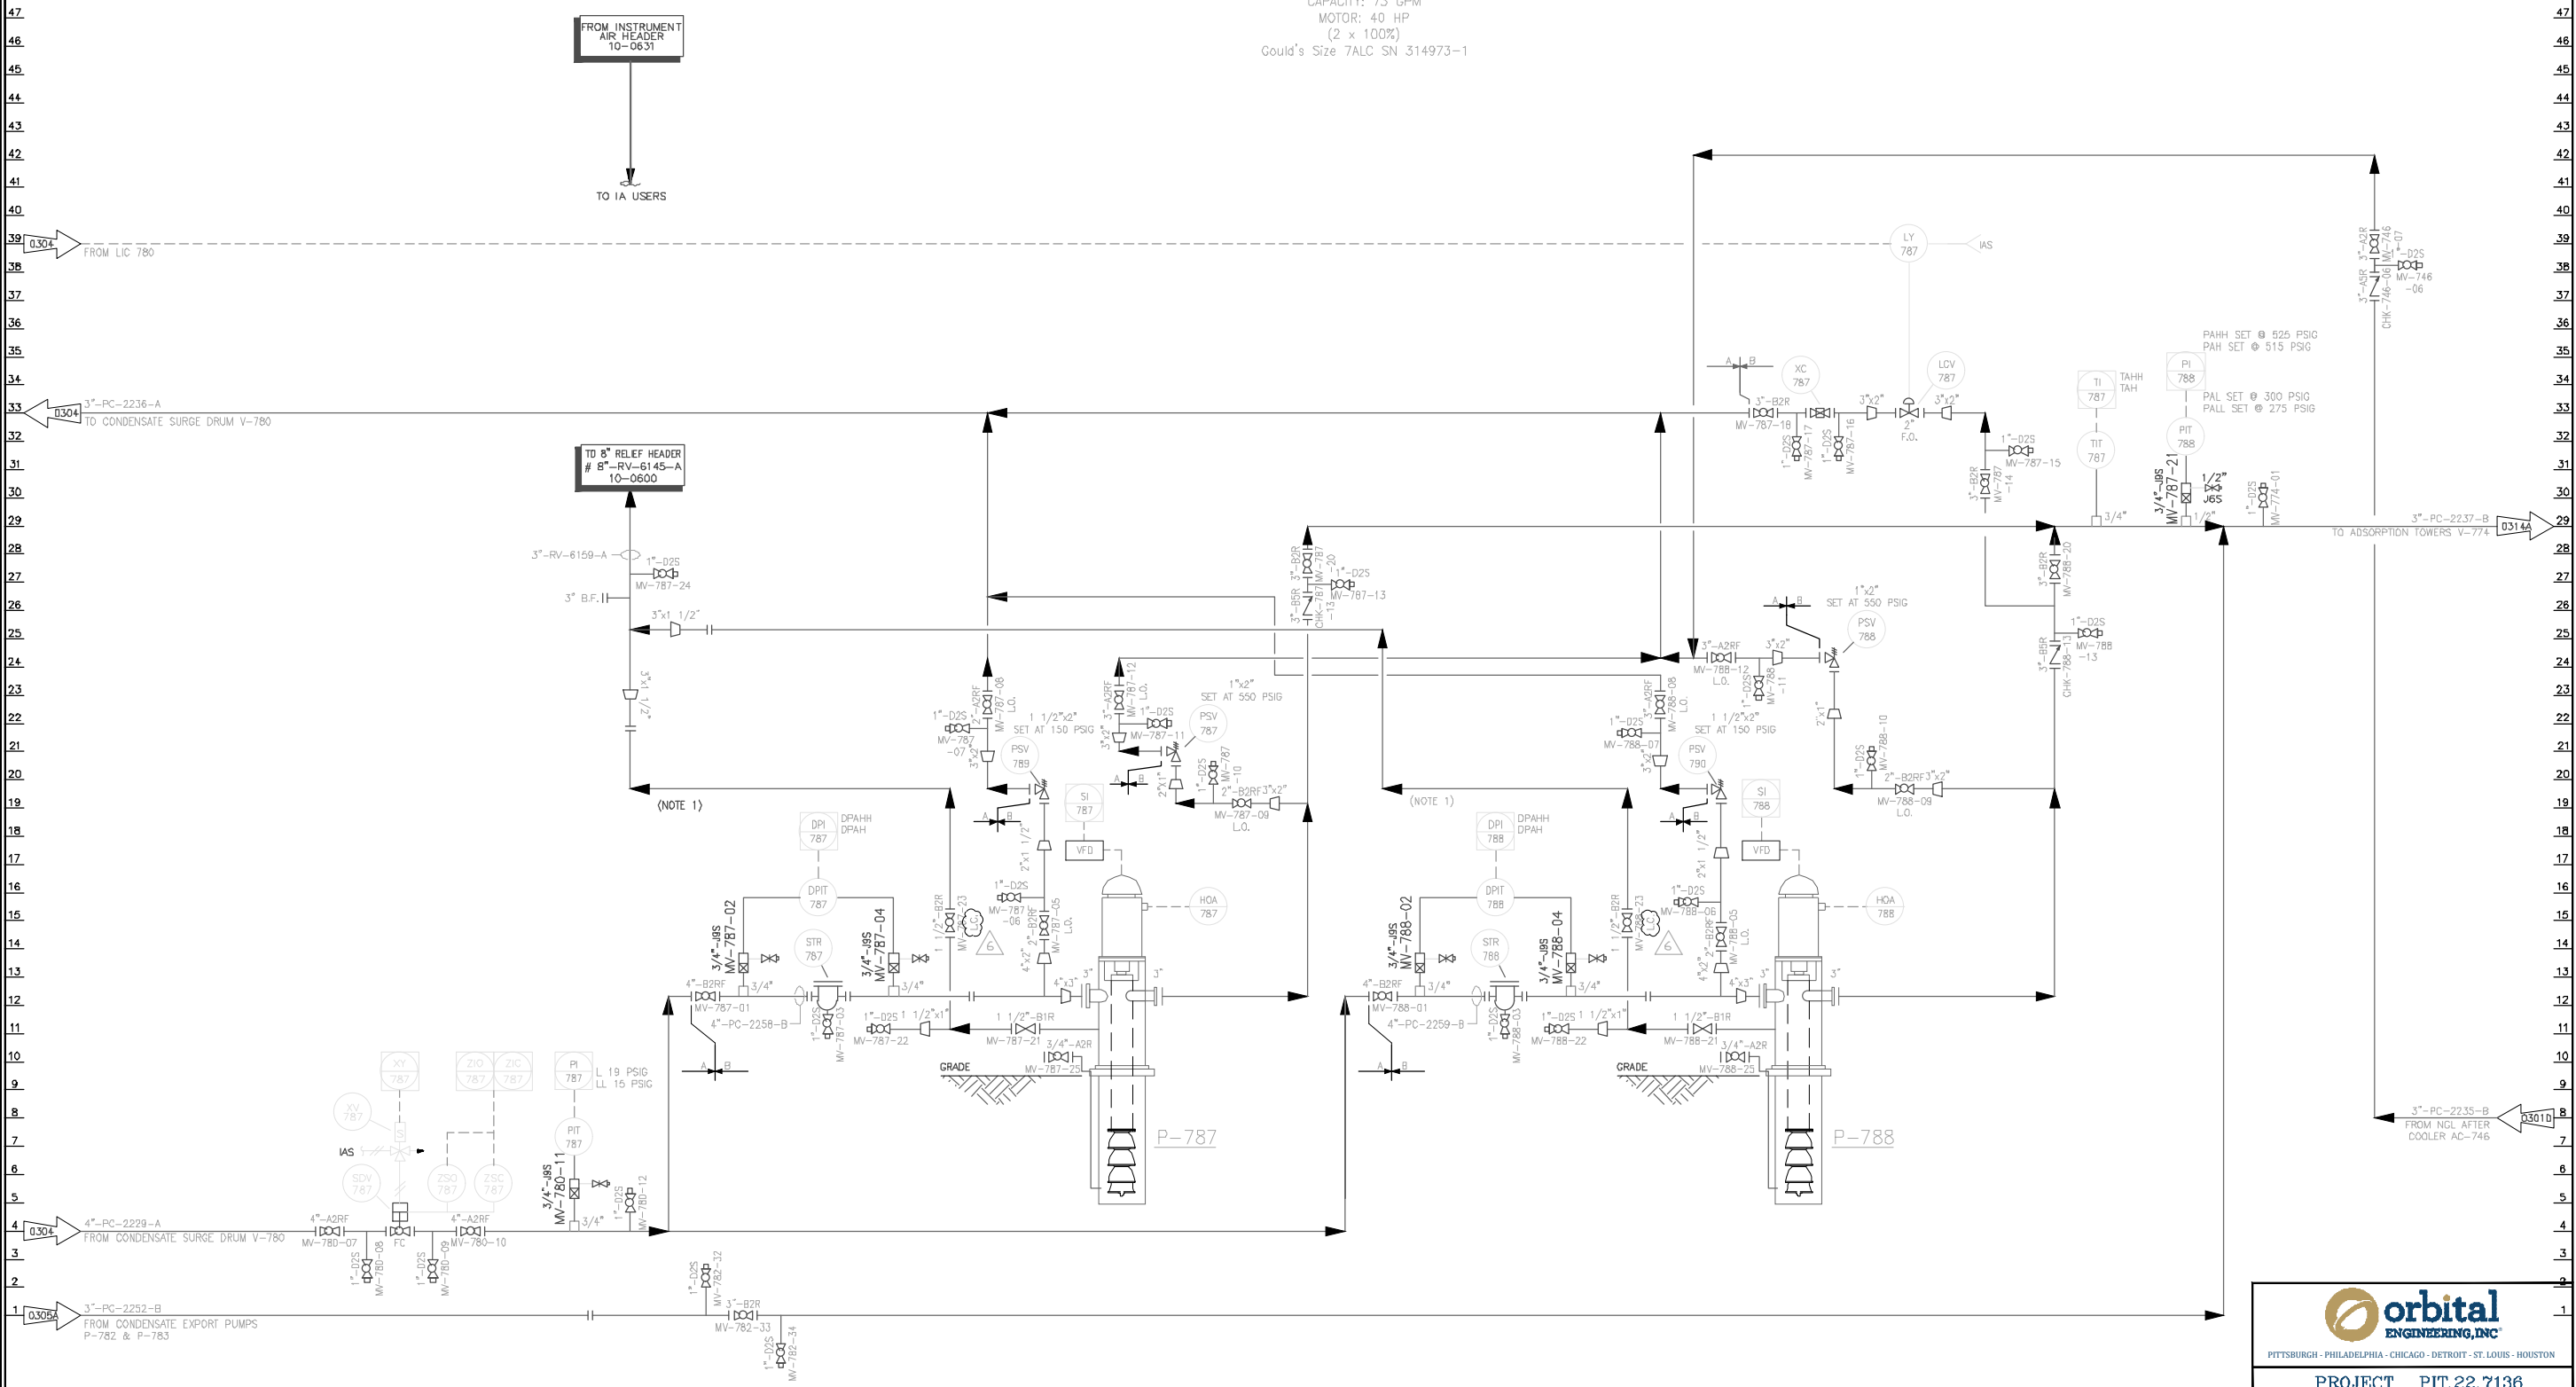

- NOTES:
- ANTI-CAVITATION VENT LINE SHOULD BE ROUTED SO THAT NO LIQUID POCKETS EXIST.
 - ALL INSTRUMENTS AND VALVES ON THIS P&ID ARE SPECIFIED BY AEC AND PURCHASED BY CONSOL.
 - THE VFDs FOR PUMPS P-787 AND P-788 WILL BE PROGRAMMED TO RAMP UP THE PUMPS TO FULL SPEED AT STARTUP.
 - SDV-787 MUST BE OPEN (ZSD-787 ACTIVE) TO START PUMP, P-787 OR P-788.



PROJECT PIT.22.7136



MARCELLUS SHALE DEVELOPMENT
MAJORSVILLE CGP
PIPING & INSTRUMENTATION DIAGRAM
CONDENSATE EXPORT PUMPS No. 2

REV.	DESCRIPTION	BY	CHK'D	APP'D	DATE	DRAWN	PH	03/11/14
6	AS-BUILT REDLINES	KBK	RCA	JMM	04/12/24			
5	REVISED PER PHA REDLINES	RCA	KBK	JMM	09/02/22			
4	AS-BUILT FOR PHA	RCA	KBK	JMM	04/01/22			
3	REVISED FOR PUMP P-787 & P-788 DATA	AZ	AZ		10/29/18			
2	REVISED FOR MOC 06302015A	CNH	KRE	BMS	08/25/15			
1	REVISED FOR MOC 10162014	KJR	KC	CB	04/08/15			
0	ISSUED FOR CONSTRUCTION	PH	JC	JD	03/11/14			